

CARD MUST BE TYPED

State of Kansas
NOTICE OF INTENTION TO DRILL

CARD MUST BE SIGNED

(see rules on reverse side)

Starting Date: 9-15-85.....
month day year

API Number 15- 051-24,303-00-00

OPERATOR: License # 7771.....

NW SE SW . . . Sec . 18 Twp 12 S, Rge 20 . . East
(location) West

Name Pan. Western Energy Corporation.....

Address 324 S. Main #711.....

City/State/Zip Tulsa, Ok 74103.....

Contact Person David Trebilcock.....

Phone (918) 582-4957.....

.....990.... Ft North from Southeast Corner of Section

.....3630.... Ft West from Southeast Corner of Section

(Note: Locate well on Section Plat on reverse side)

CONTRACTOR: License # 6394.....

Name Mohawk Drilling, Inc.....

City/State Great Bend, Kansas.....

Nearest lease or unit boundary line990..... feet.

CountyEllis.....

Lease Name ..Mai-XXXXXX PBR..... Well# 1-18....

Domestic well within 330 feet : yes no

Municipal well within one mile : yes no

Well Drilled For: Well Class: Type Equipment:

Oil Swd Infield Mud Rotary

Gas Inj Pool Ext. Air Rotary

OWWO Expl Wildcat Cable

Depth to Bottom of fresh water100..... feet

Lowest usable water formationDakota.....

Depth to Bottom of usable water950..... feet

Surface pipe by Alternate : 1 2

Surface pipe to be set250*..... feet

Conductor pipe if any required feet

Ground surface elevation feet MSL

This Authorization Expires2-26-86.....

Approved By ...8-26-85..... *PLH for KONE*

If OWWO: old well info as follows:

Operator

Well Name

Comp Date Old Total Depth

Projected Total Depth4000..... feet

Projected Formation at TD ...Arbuckle.....

Expected Producing Formations Lansing, Marmaton, Arbuckle

I certify that we will comply with K.S.A. 55-101, et seq., plus eventually plugging hole to K.C.C. specifications. *DV Tool set at anhydrite & cemented to surface. **IMMEDIATELY**


Date 8-21-85..... Signature of Operator or Agent

Title **VICE-PRESIDENT**

Must be filed with the K.C.C. five (5) days prior to commencing well
 This card void if drilling not started within six (6) months of date received by K.C.C.

Important procedures to follow:

**A Regular Section of Land
 1 Mile = 5,280 Ft.**

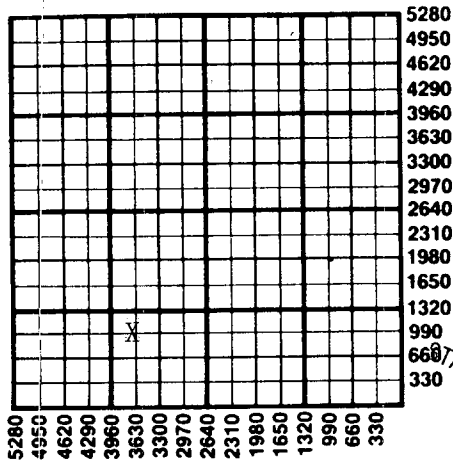

1. Notify District office before setting surface casing.
 2. Set surface casing by circulating cement to the top.
 3. File completion forms ACO-1 with K.C.C. within 90 days of well completion, following instructions on ACO-1, side 1, and including copies of wireline logs.
 4. Notify District office 48 hours prior to old well workover or re-entry.
 5. Prior to plugging, prepare a plugging plan, then obtain agreement from the appropriate district office for an approved plugging plan.
 6. Submit plugging report (CP-4) to K.C.C. after plugging is completed.
 7. Obtain an approved injection docket number before disposing of salt water.
 8. Notify K.C.C. within 10 days when injection commences or terminates.
9. If an alternate 2 completion, cement in the production pipe from below to prevent usable water to surface within 120 days of spud date.

RECEIVED
 AUG 26 1985
 08-26-1985
 STATE CORPORATION COMMISSION
 CONSERVATION DIVISION
 Wichita, Kansas

State Corporation Commission of Kansas
 Conservation Division
 200 Colorado Derby Building
 Wichita, Kansas 67202
 (316) 263-3238