

CARD MUST BE TYPED

NOTICE OF INTENTION TO DRILL

(see rules on reverse side)

CARD MUST BE SIGNED

Starting Date: Oct. 1 1984
month day year

API Number 15- 163-22,495-0000

OPERATOR: License # 5205

NE... NW... SW Sec 8... Twp 10 S, Rge 20. East
(Location) West

Name Mid-Continent Energy Corp.

Address 120 S. Market, Suite 712

City/State/Zip Wichita, KS 67202

Contact Person Larry P. Schneider

Phone 316-265-9501

2310... Ft North from Southeast Corner of Section

4290... Ft West from Southeast Corner of Section

(Note: Locate well on Section Plat on reverse side)

CONTRACTOR: License # 5418

Nearest lease or unit boundary line 330 feet.

County Rooks

Name Allen Drilling Company

Lease Name Wanker Well# 1

City/State Great Bend, KS 67530

Domestic well within 330 feet: yes no

Municipal well within one mile: yes no

Well Drilled For: Well Class: Type Equipment:

- Oil Swd Infield Mud Rotary
- Gas Inj Pool Ext. Air Rotary
- OWWO Expl Wildcat Cable

If OWWO: old well info as follows:

Operator

Well Name

Comp Date Old Total Depth

Projected Total Depth 3950 feet

Projected Formation at TD Arbuckle

Expected Producing Formations Arbuckle

Depth to Bottom of fresh water feet

Lowest usable water formation *Dakota*

Depth to Bottom of usable water *950*

Surface pipe by Alternate: 1 *2A*

Surface pipe to be set *200*

Conductor pipe if any required

Ground surface elevation

This Authorization Expires *3-21-85*

Approved By *9-21-84* *[Signature]*

I certify that we will comply with K.S.A. 55-101, et seq., plus eventually plugging hole to K.C.C. specifications.

Date *9-20-84* Signature of Operator or Agent

John N. Buchler


Title *Frank Mys.*

MHC / UONE 9/21/84

Must be filed with the K.C.C. five (5) days prior to commencing well
This card void if drilling not started within six (6) months of date received by K.C.C.

Important procedures to follow:

**A Regular Section of Land
1 Mile = 5,280 Ft.**

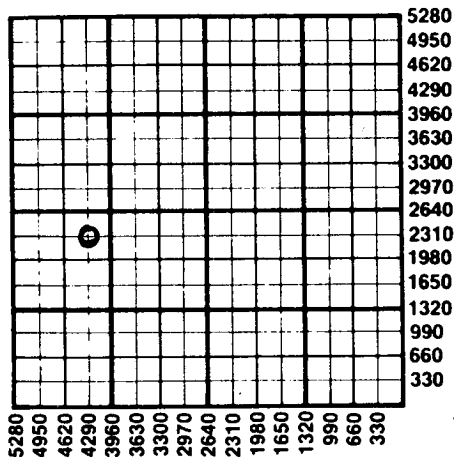

1. Notify District office before setting surface casing.
 2. Set surface casing by circulating cement to the top.
 3. File completion forms ACO-1 with K.C.C. within 90 days of well completion, following instructions on ACO-1, side 1, and including copies of wireline logs.
 4. Notify District office 48 hours prior to old well workover or re-entry.
 5. Prior to plugging, prepare a plugging plan, then obtain agreement from the appropriate district office for an approved plugging plan.
 6. Submit plugging report (CP-4) to K.C.C. after plugging is completed.
 7. Obtain an approved injection docket number before disposing of salt water.
 8. Notify K.C.C. within 10 days when injection commences or terminates.
- in alternate 20' completion, cement in the production pipe from below
any usable water to surface within 120 days of spud date.

RECEIVED
STATE CORPORATION COMMISSION
9-21-84

CONSERVATION DIVISION
Wichita, Kansas

State Corporation Commission of Kansas
Conservation Division
200 Colorado Derby Building
Wichita, Kansas 67202
(316) 263-3238