

NOTICE OF INTENTION TO DRILL

(see rules on reverse side)

Starting Date 9/10/86 month day year 1:55

OPERATOR: License # 6484 Name Thornton E. Anderson Address 212 N. Market Suite 508 City/State/Zip Wichita, KS 67202 Contact Person William L. Anderson Phone (316) 265-7929

CONTRACTOR: License # 4083 Name Western Kansas Drilling City/State Hays, KS

Well Drilled For: Oil SWD Infield Mud Rotary Gas Inj Pool Ext Air Rotary OWWO Expl Wildcat Cable

If OWWO: old well info as follows:

Operator Well Name Comp Date Old Total Depth

I certify that well will comply with K.S.A. 55-101, et seq., plus eventually plugging hole to KCC specifications.

cementing will be done immediately upon setting production casing.

Date 9/8/86 Signature of Operator or Agent William L. Anderson Title Operations Manager

For KCC Use:

Conductor Pipe Required feet; Minimum Surface Pipe Required 225 feet per Alt. 42

This Authorization Expires 3-8-87 Approved By 9-8-86

API Number 15- 051-24,428-00-00 90' S & 50' E NE. NW. SE. Sec. 34. Twp. 12. S, Rg. 18. 2220' 1600'

(Note: Locate well on Section Plat on reverse side)


Nearest lease or unit boundary line 420 feet County Ellis Lease Name Jensen Well # 1 Ground surface elevation 2087 feet MSL Domestic well within 330 feet: yes no Municipal well within one mile: yes no Surface pipe by Alternate: 1 2X Depth to bottom of fresh water 200' Depth to bottom of usable water 1200' 800' Surface pipe planned to be set 250' Projected Total Depth 3700' Formation Arbuckle

Must be filed with the K.C.C. five (5) days prior to commencing well  
This card void if drilling not started within six (6) months of date received by K.C.C.

**Important procedures to follow:**

1. Notify District office before setting surface casing.
2. Set surface casing by circulating cement to the top.
3. File completion forms ACO-1 with K.C.C. within 90 days of well completion, following instructions on ACO-1, side 1, and including copies of wireline logs.
4. Notify District office 48 hours prior to old well workover or re-entry.
5. Prior to filing Intent, prepare a proposed plugging plan in case well is D & A, then obtain approval of plan when calling district office prior to setting surface pipe.
6. Submit plugging report (CP-4) to K.C.C. after plugging is completed.
7. Obtain an approved injection docket number before disposing of salt water.
8. Notify K.C.C. within 10 days when injection commences or terminates.
9. If an alternate 2 completion, cement in the production pipe from below any usable water to surface within 120 days of spud date.

**A Regular Section of Land**  
**1 Mile = 5,280 Ft.**

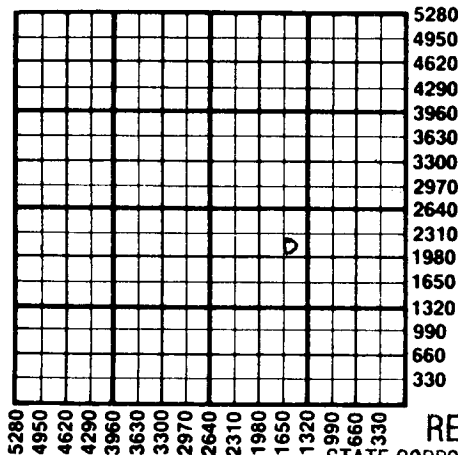

RECEIVED  
STATE CORPORATION COMMISSION

SEP 8 - 1986  
09-08-1986  
CONSERVATION DIVISION  
Wichita, Kansas

State Corporation Commission of Kansas  
Conservation Division  
200 Colorado Derby Building  
Wichita, Kansas 67202  
(316) 263-3238