

15-051-19251-00-00

NOTICE OF INTENTION TO DRILL

(see rules on reverse side)

Dakota study

Starting Date 2 month 5 day 87 year

API Number 15-

OPERATOR: License # Kansas Geological Survey
Name 1930 Constant Ave
Address Lawrence, Kansas 66046
City/State/Zip P. Allen Macfarlane
Contact Person (913) 864-3965
Phone

NE NE NE Sec. 30 Twp. 12 S, Rg. 18 East
4950 Ft. from South Line of Section
75 Ft. from East Line of Section

(Note: Locate well on Section Plat on reverse side)

CONTRACTOR: License # 134
Name Rosencrantz-Bemis
City/State Great Bend, Kansas

Nearest lease or unit boundary line feet
County Ellis

Lease Name Braun Well # 1
Ground surface elevation 2140 feet MSL

Well Drilled For: Well Class: Type Equipment:
Oil SWD Infield Mud Rotary
Gas Inj Pool Ext Air Rotary
OWWO Exp Wildcat Cable

Domestic well within 300 feet: yes no
Municipal well within one mile: yes no

Depth to bottom of fresh water 750
Depth to bottom of usable water 900

If OWWO: old well info as follows:
Operator
Well Name
Comp Date Old Total Depth

Surface pipe by Alternate: 1 2
Surface pipe planned to be set 1150

Conductor pipe required
Projected Total Depth 1150 feet
Formation Cedar Hills Sandstone

I certify that well will comply with K.S.A. 55-101, et seq., plus eventually plugging hole to KCC specifications.

Date 2/4/87 Signature of Operator or Agent P. Allen Macfarlane Title Hydrogeologist

For KCC Use:

Conductor Pipe Required feet; Minimum Surface Pipe Required feet per Alt. 1 2


This Authorization Expires Approved By

Must be filed with the K.C.C. five (5) days prior to commencing well  
This card void if drilling not started within six (6) months of date received by K.C.C.

### Important procedures to follow:

1. Notify District office before setting surface casing.
2. Set surface casing by circulating cement to the top.
3. File completion forms ACO-1 with K.C.C. within 90 days of well completion, following instructions on ACO-1, side 1, and including copies of wireline logs.
4. Notify District office 48 hours prior to old well workover or re-entry.
5. Prior to filing Intent, prepare a proposed plugging plan in case well is D & A, then obtain approval of plan when calling district office prior to setting surface pipe.
6. Submit plugging report (CP-4) to K.C.C. after plugging is completed.
7. Obtain an approved injection docket number before disposing of salt water.
8. Notify K.C.C. within 10 days when injection commences or terminates.
9. If an alternate 2 completion, cement in the production pipe from below any usable water to surface within 120 days of spud date.

### A Regular Section of Land 1 Mile = 5,280 Ft.

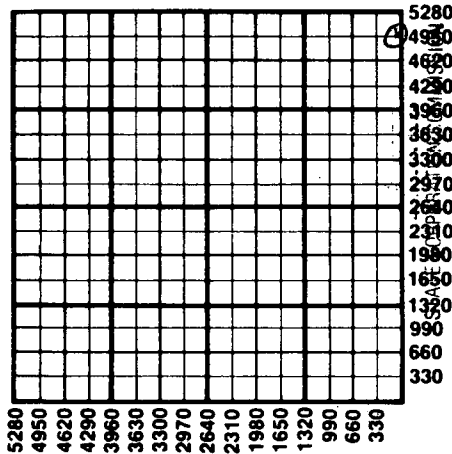

2/13/87

FEB 12 1987

CONSERVATION DIVISION  
Wichita, Kansas

State Corporation Commission of Kansas  
Conservation Division  
200 Colorado Derby Building  
Wichita, Kansas 67202  
(316) 263-3238