


WELL PLUGGING RECORD

Give All Information Completely
Make Required Affidavit
Mail or Deliver Report to:
Conservation Division
State Corporation Commission
212 No. Market
Wichita, Kansas

NORTH

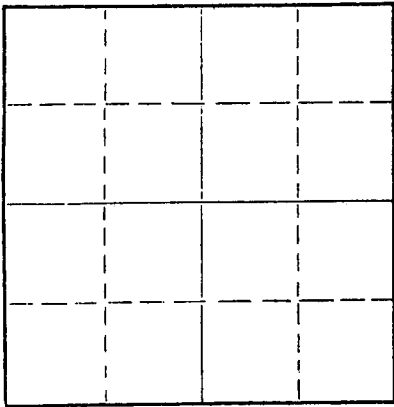

Locate well correctly on above
Section Plat

Ellis County. Sec. 8 Twp. 12 Rge. 20 (E) W (W)
Location as "NE/CNWxSWx" or footage from lines SW NW NW
Lease Owner Prospect Oil, Inc. & Shields Oil Producers, Inc.
Lease Name Karlin Well No. 1
Office Address 811 Union Center Bldg., Wichita, Kansas
Character of Well (completed as Oil, Gas or Dry Hole) Dry hole
Date well completed April 19 1968
Application for plugging filed April 19 1968
Application for plugging approved April 19 1968
Plugging commenced April 19 1968
Plugging completed April 19 1968
Reason for abandonment of well or producing formation

If a producing well is abandoned, date of last production 19
Was permission obtained from the Conservation Division or its agents before plugging was commenced?

Name of Conservation Agent who supervised plugging of this well Leo Massey
Producing formation Depth to top Bottom Total Depth of Well 3,968 Feet
Show depth and thickness of all water, oil and gas formations.

OIL, GAS OR WATER RECORDS

CASING RECORD

FORMATION	CONTENT	FROM	TO	SIZE	PUT IN	PULLED OUT
				8 5/8"	210'	Cmtd. w/ 160 sax

Describe in detail the manner in which the well was plugged, indicating where the mud fluid was placed and the method or methods used in introducing it into the hole. If cement or other plugs were used, state the character of same and depth placed, from feet to feet for each plug set.

Fill w/ heavy mud to 800'
Set bridge plug @ 800'
Halliburton pumped 70 sax cement on plug thru 4 1/2" drill pipe
Fill w/ heavy mud to 180'
Set bridge plug @ 180'
Halliburton pumped 20 sax cement on plug thru 4 1/2" drill pipe
Fill w/ heavy mud to 40'
Set bridge plug @ 40' w/ 1/2 sax hulls on plug
Dump 10 sax cement on plug to cellar

RECEIVED
STATE CORPORATION COMMISSION
MAY 2 1968
CONSERVATION DIVISION
Wichita, Kansas

05-02-1968

(If additional description is necessary, use BACK of this sheet)

Name of Plugging Contractor Shields Drilling Co., Inc.
Address Shields Bldg., Russell, Kansas

STATE OF Kansas, COUNTY OF Russell, ss.
R. J. Shields (employee of owner) or (owner or operator) of the above-described well, being first duly sworn on oath, says: That I have knowledge of the facts, statements, and matters herein contained and the log of the above-described well as filed and that the same are true and correct. So help me God.

(Signature) R. J. Shields
Shields Bldg., Russell, Kansas
(Address)

SUBSCRIBED AND SWORN TO before me this 30th day of April, 1968

Lush Phillips
Notary Public.

My Commission expires May 26, 1971






Shields

WELL LOG

Russell, Kansas
15-051-20239-00-00

Operator: Prospect Oil, Inc. &
Shields Oil Producers, Inc.
Well: Karlin #1
Commenced: April 10, 1968
Completed: April 19, 1968
Contractor: Shields Drilling Co., Inc.

Well Description: SW NW NW
Sec. 8-12S-20W
Ellis Co., Kansas

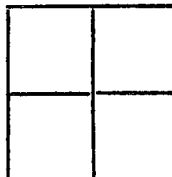

CASING RECORD
Size Run Pulled
8 5/8" 210' Cmtd. w/ 160 sax

Elevation: 2,288' RB

Treatment:

Production: D & A

Tops: Heebner 3,542'
Toronto 3,567'
Lansing - KC 3,580'
Conglomerate 3,907'
Arbuckle 3,924'

..... Figures Indicate Bottom of Formations

Rock	40'
Shale	215'
Shale, shells & sand	1,150'
Sand, shale & redbed	1,673'
Anhydrite	1,718'
Shale & shells	1,820'
Shale, shells & salt	2,240'
Shale & lime	2,350'
Lime	2,675'
Lime & shale	3,300'
Lime	3,968' RTD

RECEIVED
STATE CORPORATION COMMISSION
MAY 2 1968
CONSERVATION DIVISION
Wichita, Kansas
05-02-1968

NOTES

DST #1 3,772' - 3,800' Tool open 1 hr. w/ weak blow thruout.
Recovered 40' muddy water. IBHP - 1,140#,
IFP - 24#, FFP - 47#, FBHP - 1,089#/30 min.

DST #2 3,926' - 3,936' Tool open 1 hr. w/ weak blow thruout.
Recovered 55' OCM., IBHP - 653#, IFP - 10#,
FFP - 26#, FBHP - 466#/30 min.

DST #3 3,936' - 3,943' Tool open 1 hr. w/ weak blow thruout.
Recovered 65' OCM. IBHP - 767#, IFP - 21#,
FFP - 31#, FBHP - 663#/30 min.

DST #4 3,943' - 3,968' Tool open 1 hr. w/ slight blow. Recovered
60' OCWM, 60' muddy water w/ scum oil,
360' muddy water. IBHP - 1,192#, IFP - 52#,
FFP - 232#, FBHP - 1,068#/30 min.