

15-051-20736-00-00

STATE OF KANSAS  
STATE CORPORATION COMMISSION


Form CP-4

WELL PLUGGING RECORD

Give All Information Completely  
Make Required Affidavit  
Mail or Deliver Report to:  
Conservation Division  
State Corporation Commission  
212 No. Market  
Wichita, Kansas

Ellis County. Sec. 8 Twp. 12S Rge. 20W (E)\_\_\_\_(W)  
Location as "NE/CNW&SW" or footage from lines SE SE NW  
Lease Owner Richard W. Norton, Jr. & Robert M. Bergstein  
Lease Name Karlin Well No. 2  
Office Address P. O. Box 1666, Shreveport, La. 71102  
Character of Well (completed as Oil, Gas or Dry Hole) Dry Hole  
Date well completed May 14 19 69  
Application for plugging filed May 14 19 69  
Application for plugging approved May 14 19 69  
Plugging commenced May 14 19 69  
Plugging completed May 14 19 69  
Reason for abandonment of well or producing formation Dry Hole

NORTH

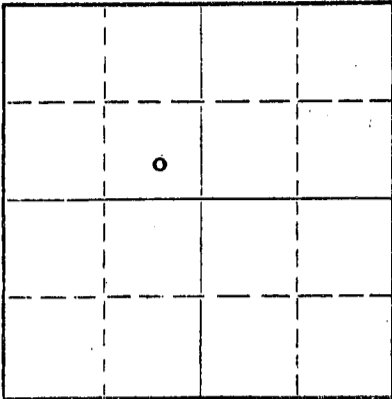

Locate well correctly on above  
Section Plat

If a producing well is abandoned, date of last production \_\_\_\_\_ 19\_\_\_\_  
Was permission obtained from the Conservation Division or its agents before plugging was commenced? Yes

Name of Conservation Agent who supervised plugging of this well Leo Massey, Box 582, Hays, Kansas  
Producing formation \_\_\_\_\_ Depth to top \_\_\_\_\_ Bottom \_\_\_\_\_ Total Depth of Well 4050 Feet  
Show depth and thickness of all water, oil and gas formations.

OIL, GAS OR WATER RECORDS

CASING RECORD

FORMATION	CONTENT	FROM	TO	SIZE	PUT IN	PULLED OUT
		0	247'	8 5/8"	247'	None

Describe in detail the manner in which the well was plugged, indicating where the mud fluid was placed and the method or methods used in introducing it into the hole. If cement or other plugs were used, state the character of same and depth placed, from \_\_\_\_\_ feet to \_\_\_\_\_ feet for each plug set.

Plug: 70 sacks cement @ 800' thru D.P.  
20 sacks cement @ 240' thru D.P.  
10 sacks cement @ 40' on solid bridge

RECEIVED  
STATE CORPORATION COMMISSION  
MAY 23 1969  
CONSERVATION DIVISION  
Wichita, Kansas

OS-23-1969

(If additional description is necessary, use BACK of this sheet)

Name of Plugging Contractor Hellar Drilling Company, Inc.  
Address 339 Union Center Bldg., Wichita, Kansas 67530


STATE OF Kansas, COUNTY OF Sedgwick, ss.  
D. L. Hellar, Pres. of Hellar Drilling Company, Inc. (employee of owner) or (owner or operator) of the above-described well, being first duly sworn on oath, says: That I have knowledge of the facts, statements, and matters herein contained and the log of the above-described well as filed and that the same are true and correct. So help me God.

(Signature) D. L. Hellar D. L. Hellar, President  
339 Union Center Bldg., Wichita, Kansas 67202

(Address)

DESCRIBED AND SWORN to before me this 22nd day of May, 19 69  
Catherine Darcey  
Catherine Darcey Notary Public.

commission expires March 25, 1972

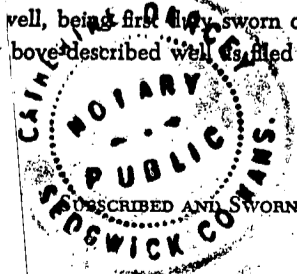

15-051-20436-00-00

DRILLER'S LOG

COMPANY: Richard W. Norton, Jr. & Robert M. Bergstein  
 P. O. Box 1666, Shreveport, La. 71102

CONTRACTOR: Hellar Drilling Company, Inc., Wichita, Kansas 67202

LEASE: #2 Karlin

LOCATION: SE SE NW 8-12S-20W, Ellis County, Kansas

COMMENCED: May 6, 1969

COMPLETED: May 14, 1969

CASING: Set 8 5/8" Surface Casing @ 247'/170 sacks cement

0-50	Post Rock & Shale
50-250	Sand & Shale
250-1265	Shale, Sand & Shells
1265-1510	Shale & Sand
1510-1697	Shale
1697-1738	Anhydrite
1738-2230	Shale & Lime
2230-2475	Cherty Lime & Shale
2475-3965	Lime & Shale
3965-4010	Lime & Dolomite
4010-4050	Lime & Shale
4050	Rotary Total Depth

D & A

RECEIVED  
 STATE CORPORATION COMMISSION  
 MAY 23 1969  
 CONSERVATION DIVISION  
 Wichita, Kansas

05-23-1969

STATE OF KANSAS )  
 ) SS  
 COUNTY OF SEDGWICK )


I, D. L. Hellar, do hereby certify that the above and foregoing is a true and correct copy of the log of the #2 Karlin, located in SE SE NW 8-12S-20W, Ellis County, Kansas, as reflected by the files of the Hellar Drilling Company, Inc.

HELLAR DRILLING COMPANY, INC.

By *D. L. Hellar*  
 President - D. L. Hellar

Subscribed and sworn to before me, a Notary Public, in and for Sedgwick County, Kansas, this 22nd day of May, 1969.

*Catherine Darcey*  
 Notary Public - Catherine Darcey

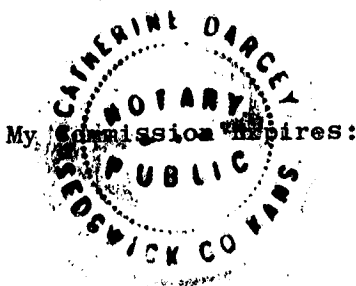

March 25, 1972.