


Give All Information Completely  
Make Required Affidavit  
Mail or Deliver Report to:  
Conservation Division  
State Corporation Commission  
212 No. Market  
Wichita, Kansas

WELL PLUGGING RECORD

NORTH

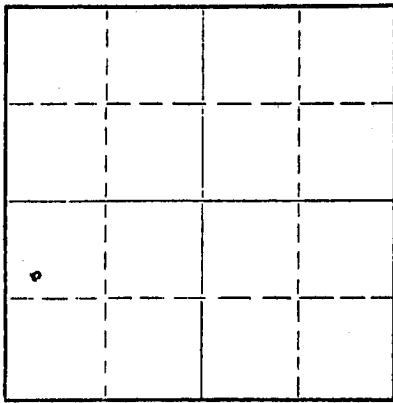

Locate well correctly on above  
Section Plat

Ellis County. Sec. 18 Twp. 12S Rge. (E) 20 (W)  
Location as "NE/CNW/SW" or footage from lines SW NW SW  
Lease Owner Home-Stake Production Company  
Lease Name Mai Well No. 1  
Office Address 1015 Philtower, Tulsa, Oklahoma  
Character of Well (completed as Oil, Gas or Dry Hole) oil  
Date well completed \_\_\_\_\_ 19\_\_\_\_  
Application for plugging filed April 10 19 69  
Application for plugging approved \_\_\_\_\_ 19\_\_\_\_  
Plugging commenced April 29 19 69  
Plugging completed May 14 19 69  
Reason for abandonment of well or producing formation depleted

If a producing well is abandoned, date of last production \_\_\_\_\_ 19\_\_\_\_  
Was permission obtained from the Conservation Division or its agents before plugging was commenced? YES

Name of Conservation Agent who supervised plugging of this well Leo Massey  
Producing formation \_\_\_\_\_ Depth to top \_\_\_\_\_ Bottom \_\_\_\_\_ Total Depth of Well 4050 Feet  
Show depth and thickness of all water, oil and gas formations.

OIL, GAS OR WATER RECORDS

CASING RECORD

FORMATION	CONTENT	FROM	TO	SIZE	PUT IN	PULLED OUT
		0	247'	8 5/8"	247'	none
		0	4041'	5 1/2"	4041'	2824'

Describe in detail the manner in which the well was plugged, indicating where the mud fluid was placed and the method or methods used in introducing it into the hole. If cement or other plugs were used, state the character of same and depth placed, from \_\_\_\_\_ feet to \_\_\_\_\_ feet for each plug set.

Filled hole with sand from 4041' to 3920'.

Squeezed well with 2 sacks hulls and 25 sacks of gel mud and 140 sacks of cement.

RECEIVED  
STATE CORPORATION COMMISSION  
JUN 3 1969  
CONSERVATION DIVISION  
Wichita, Kansas  
06-03-1969

(If additional description is necessary, use BACK of this sheet)

Name of Plugging Contractor Pipe Pullers, Inc.  
Address Box 486, Ellinwood, Kansas

STATE OF Kansas, COUNTY OF Barton, ss.  
Evelyn Roth (employee of owner) or (owner or operator) of the above-described

well, being first duly sworn on oath, says: That I have knowledge of the facts, statements, and matters herein contained and the log of the above-described well as filed and that the same are true and correct. So help me God.

(Signature) Evelyn Roth  
Ellinwood, Kansas (Address)

SUBSCRIBED AND SWORN TO before me this 22nd day of May, 1969

My commission expires Feb. 10, 1971  
George A. Meyer Notary Public.

