


WELL PLUGGING RECORD

Give All Information Completely  
Make Required Affidavit  
Mail or Deliver Report to:  
Conservation Division  
State Corporation Commission  
800 Bittling Building  
Wichita, Kansas

NORTH

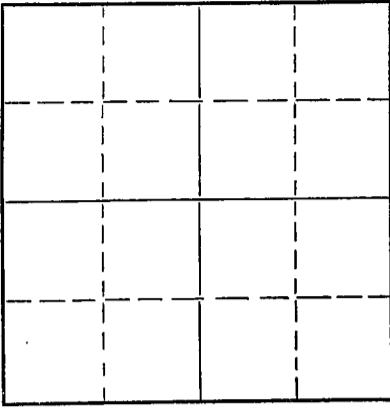

Locate well correctly on above  
Section Plat

Ellis County. Sec. 18 Twp. 12S Rge. 20 (NE) (W)  
Location as "NE/CNW&SW&" or footage from lines NW NW SE  
Lease Owner Victor Drilling, Inc.  
Lease Name Armbrister Well No. 1  
Office Address 302 Koch Building, Wichita, Kansas  
Character of Well (completed as Oil, Gas or Dry Hole) Dry Hole  
Date well completed June 11 19 54  
Application for plugging filed June 11 19 54  
Application for plugging approved June 11 19 54  
Plugging commenced June 11 19 54  
Plugging completed June 11 19 54  
Reason for abandonment of well or producing formation Dry Hole

If a producing well is abandoned, date of last production 19  
Was permission obtained from the Conservation Division or its agents before plugging was commenced? Yes

Name of Conservation Agent who supervised plugging of this well Eldon Petty  
Producing formation \_\_\_\_\_ Depth to top \_\_\_\_\_ Bottom \_\_\_\_\_ Total Depth of Well 4037 Feet  
Show depth and thickness of all water, oil and gas formations.

OIL, GAS OR WATER RECORDS

CASING RECORD

FORMATION	CONTENT	FROM	TO	SIZE	PUT IN	PULLED OUT
		0	214	8 5/8"	214	0

Describe in detail the manner in which the well was plugged, indicating where the mud fluid was placed and the method or methods used in introducing it into the hole. If cement or other plugs were used, state the character of same and depth placed, from \_\_\_\_\_ feet to \_\_\_\_\_ feet for each plug set.

4037 to 214 filled hole with heavy rotary mud  
Set plug at 210' with 15 sacks cement  
Set plug at 40' with 10 sacks cement

RECEIVED  
STATE CORPORATION COMMISSION  
JUN 23 1954  
06-23-1954  
CONSERVATION DIVISION  
Wichita, Kansas

(If additional description is necessary, use BACK of this sheet)


Name of Plugging Contractor \_\_\_\_\_  
Address \_\_\_\_\_

STATE OF Kansas, COUNTY OF Sedgwick, ss.  
I, Patrick F. Gallagher (employee of owner) or owner or operator) of the above-described well, being first duly sworn on oath, says: That I have knowledge of the facts, statements, and matters herein contained and the log of the above-described well as filed and that the same are true and correct. So help me God.

(Signature) Patrick F. Gallagher  
302 Koch Building, Wichita, Kansas  
(Address)

SUBSCRIBED AND SWORN TO before me this 23rd day of June, 19 54.

My commission expires August 18, 19 54,  
Sylvia Rhinehart  
Notary Public.

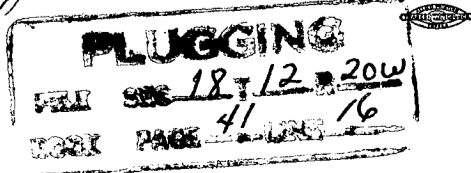

DRILLER'S LOG

15-051-00781-00-00

NAME: Armbrister #1  
 LOCATION: NW NW SE Section 18-12S-20W, Ellis County, Kansas  
 Drilling Commenced: June 1, 1954  
 Drilling Ended: June 11, 1954  
 Casing: Ran 7 jts. 8 5/8" 24# casing set at 214' w/100 sacks cement

FROM	TO	FORMATION
0	214	Surface pipe
214	825	Shale
825	1115	Shale
1115	1485	Sandy shale & red bed
1485	1705	Red bed & shale
1705	1750	Anhydrite
1750	1885	Shale & salt
1885	2190	Shale & lime
2190	2260	Shale & salt
2260	2450	Shale & lime
2450	2625	Shale & lime streaks
2625	2710	Shale & lime
2710	2880	Shale & lime
2880	3170	Shale
3170	3344	Shale & lime streaks
3344	3506	Shale & lime
3506	3576	Lime
3576	3620	Lime & shale
3620	3675	Lime
3675	3757	Lime & shale
3757	3767	Shale
3767	3785	Lime
3785	3894	Lime & shale
3894	3925	Shale & lime
3925	3954	Conglomerate
3954	4007	Conglomerate sand & chert
4007	4037	Arbuckle dolomite
4037		TD

STATE OF KANSAS )  
 ) SS:  
 COUNTY OF SEDGWICK)

I, the undersigned, P. F. Gallagher, drilling contractor, do hereby certify that the above is a true and correct copy of the Driller's Log of formations for the above well.

P. F. Gallagher  
 P. F. Gallagher

Subscribed and sworn to before me, a Notary Public, in and for the said County in the state aforesaid this 23rd day of June, 1954.

Sylvia Rhinehart  
 Notary Public  
 My commission expires: Aug. 18-1954

RECEIVED  
 STATE OF KANSAS COMMISSION  
 JUN 23 1954  
 COUNTY OF SEDGWICK DIVISION  
 WICHITA, KANSAS

**PLUGGING**  
 FILE SEC 18 T 12 R 20W  
 BOOK PAGE 41 LINE 16