


WELL PLUGGING RECORD

Give All Information Completely  
Make Required Affidavit  
Mail or Deliver Report to:  
Conservation Division  
State Corporation Commission  
211 No. Broadway  
Wichita, Kansas

Ellis County, Sec. 17 Twp. 12 Rge. 20 (E) (W) X

NORTH

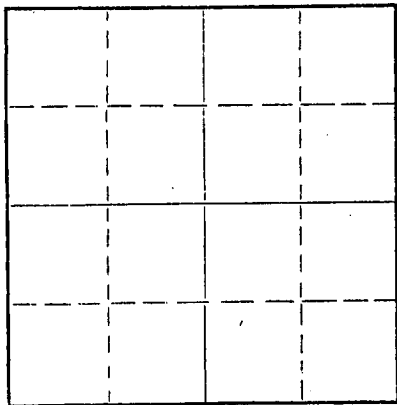

Locate well correctly on above  
Section Plat

Location as "NE/CNW/SW" or footage from lines SE Corner  
Lease Owner Woodman & Iannitti Drilling Co.  
Lease Name Armbruster Well No. 1  
Office Address 714 Union National Bldg.  
Character of Well (completed as Oil, Gas or Dry Hole) Dry  
Date well completed 11-26-59 19  
Application for plugging filed 11-26-59 19  
Application for plugging approved 11-26-59 19  
Plugging commenced 11-26-59 19  
Plugging completed 11-26-59 19  
Reason for abandonment of well or producing formation Dry

If a producing well is abandoned, date of last production \_\_\_\_\_ 19\_\_\_\_  
Was permission obtained from the Conservation Division or its agents before plugging was commenced? Yes

Name of Conservation Agent who supervised plugging of this well Eldon Petty  
Producing formation \_\_\_\_\_ Depth to top \_\_\_\_\_ Bottom \_\_\_\_\_ Total Depth of Well 4000 Feet  
Show depth and thickness of all water, oil and gas formations.

OIL, GAS OR WATER RECORDS

CASING RECORD

FORMATION	CONTENT	FROM	TO	SIZE	PUT IN	PULLED OUT
				8 5/8"	160'	

Describe in detail the manner in which the well was plugged, indicating where the mud fluid was placed and the method or methods used in introducing it into the hole. If cement or other plugs were used, state the character of same and depth placed, from \_\_\_\_\_ feet to \_\_\_\_\_ feet for each plug set.

Bottom Plug 660' with 20 sacks  
Middle Plug 180' with 20 sacks  
Top Plug 40' with 10 sacks

RECEIVED  
STATE CORPORATION COMMISSION  
NOV 30 1959  
11-30-1959  
CONSERVATION DIVISION  
Wichita, Kansas

(If additional description is necessary, use BACK of this sheet)

Name of Plugging Contractor Woodman & Iannitti Drilling Co.  
Address Box 387, Hoisington, Kansas

STATE OF KANSAS, COUNTY OF SEDGWICK, ss.  
K. T. Woodman (employee of owner) or (owner or operator) of the above-described well, being first duly sworn on oath, says: That I have knowledge of the facts, statements, and matters herein contained and the log of the above-described well as filed and that the same are true and correct. So help me God.


(Signature) K. T. Woodman

K. T. Woodman 714 Union Natl Bldg.  
(Address) Wichita, Kans.

SUBSCRIBED AND SWORN TO before me this 27th day of November, 1959

Lois N. Gow  
Lois N. Gow Notary Public.

My commission expires December 21, 1961

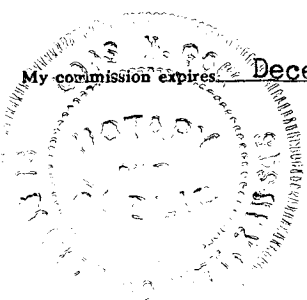

15-051-00365-00-00

11-30-1959

DRILLING LOG

L.I. DIVISION  
Topeka, Kansas

Company: Woodman & Iannitti Drilling Co.  
 Lease: #1 Armbruster SE Corner 17-12-20W Ellis Co. Kans.  
 Contractor: Woodman & Iannitti Drilling Co.  
 P. O. Box 387, Hoisington, Kansas  
 Date Commenced: 11-18-59  
 Date Completed: 11-26-59  
 Total Depth: 4000'  
 Casing: 8 5/8" at 160' with 130 sacks quick-set cement.

Figures Indicate the Bottom of Formation

0-15	Sand	1830-2200	Shale & Shells
125	Shale	2315	Lime
135	Sand	2660	Lime
188	Shale Blue	2755	Broken Lime
540	Shale	2950	Lime & Shale
800	Shale	3230	Lime
1100	Sand Shale	3310	Lime & Shale
1300	Sand	3370	Lime topeka
1450	Red Bed	3725	Lime
1630	Shale & Shells	3843	Lime
1674	Anhydrite	3940	Lime
1839	Shale & Shells	3949	Lime
		3988	Arbuckle Dolomite
		4000	Dolomite

GEOLOGICAL TOPS

Elevation	2264	RB
Anhydrite	1630	+ 634
Heebner	3532	-1268
Lansing	3570	-1306
Cong.	3872	-1608
Arbuckle	3945	-1681
Total Depth	4000	-1736

I certify the above to be a true and correct copy of the Driller's Log and Geological Tops to the best of my knowledge and belief.

WOODMAN & IANNITTI DRILLING CO.

By: K. T. Woodman  
K. T. Woodman