


WELL PLUGGING RECORD

Give All Information Completely
Make Required Affidavit
Mail or Deliver Report to:
Conservation Division
State Corporation Commission
211 No. Broadway
Wichita, Kansas

Ellis County, Sec. 17 Twp. 12 Rge. 20 (NE) W(W)
Location as "NE/CNW/SE/SW" or footage from lines NE NE NW
Lease Owner Nadel and Gussman
Lease Name Reitmeyer Well No. 1
Office Address 1714 First Natl Bldg. Tulsa 3, Oklahoma
Character of Well (completed as Oil, Gas or Dry Hole) Dry
Date well completed 7-21 1958
Application for plugging filed 7-21 1958
Application for plugging approved 7-21 1958
Plugging commenced 7-21 1958
Plugging completed 7-21 1958
Reason for abandonment of well or producing formation Dry

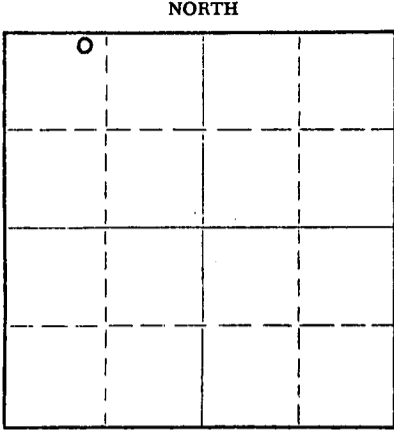

Locate well correctly on above
Section Plat

If a producing well is abandoned, date of last production _____ 19____
Was permission obtained from the Conservation Division or its agents before plugging was commenced? Yes

Name of Conservation Agent who supervised plugging of this well _____
Producing formation _____ Depth to top _____ Bottom _____ Total Depth of Well 4000 Feet
Show depth and thickness of all water, oil and gas formations.

OIL, GAS OR WATER RECORDS

CASING RECORD

FORMATION	CONTENT	FROM	TO	SIZE	PUT IN	PULLED OUT
				8-5/8"	201'	0

Describe in detail the manner in which the well was plugged, indicating where the mud fluid was placed and the method or methods used in introducing it into the hole. If cement or other plugs were used, state the character of same and depth placed, from _____ feet to _____ feet for each plug set.

Filled hole with heavy mud from T.D. to 675' - set plug with 20 sacks cement. Heavy mud to 180' and set plug with 20 sacks cement. Top plug at 40' with 10 sacks cement.

(If additional description is necessary, use BACK of this sheet)

Name of Plugging Contractor Reserve Drilling Company, Inc.
Address 625 Union Center, Wichita 2, Kansas

STATE OF KANSAS, COUNTY OF SEDGWICK, ss.
L. C. Hay (employee of owner) of the above-described well, being first duly sworn on oath, says: That I have knowledge of the facts, statements, and matters herein contained and the log of the above-described well as filed and that the same are true and correct. So help me God.

(Signature) L. C. Hay
Wichita, Kansas (Address)

SUBSCRIBED AND SWORN TO before me this 24th day of July, 1958

My commission expires Nov. 3, 1960 _____ Notary Public.

PLUGGING
 FILE SEC. 17 T. 12 R. 20W
 BOOK PAGE 110 LINE 40

AUG 14 1958
 08-14-1958
 CONSERVATION DIVISION
 WICHITA, KANSAS

WELL LOG

15-051-01240-00-00

NADEL AND GUSSMAN

REITMEYER No. 1

NE NE NW 17-12-20W
Ellis County, Kansas

Comm: 7-8-58
Comp: 7-21-58

Casing: 8-5/8" 201' w/135 sax

<u>Formations</u>	<u>Depths</u>
Rock, shale and sand	130
Shale	410
Shale and shells	870
Shale and sand streaks	990
Sand, shale and pyrite streaks	1120
Sand	1370
Shale	1655
Anhydrite	1705
Shale and shells	1900
Shale and lime	2405
Lime	2595
Lime and shale	3460
Lime	3885
Lime and chert	3924
Cherty lime	3974
Lime	3980
Arbuckle	4000

Geological Tops

Heebner	3560
Lansing	3597
Arbuckle	3970

STATE OF KANSAS)
) SS:
 COUNTY OF SEDGWICK)

Nola Babb, of lawful age, states that the above formations and depths are correct to her best knowledge.

Nola Babb

Subscribed and sworn to before me this 28th day of July, 1958.

K. Lucile French

My commission expires June 17, 1962

PLUGGING
 FILE SEC. 17 T. 12. R. 20W
 BOOK PAGE 118 LINE 40

08-14-1958
 CONSERVATION DIVISION
 Wichita, Kansas