


STATE OF KANSAS
STATE CORPORATION COMMISSION

15-051-04482-00-00
WELL PLUGGING RECORD

Give All Information Completely
Make Required Affidavit
Mail or Deliver Report to:
Conservation Division
State Corporation Commission
800 Bitting Building
Wichita, Kansas

NORTH

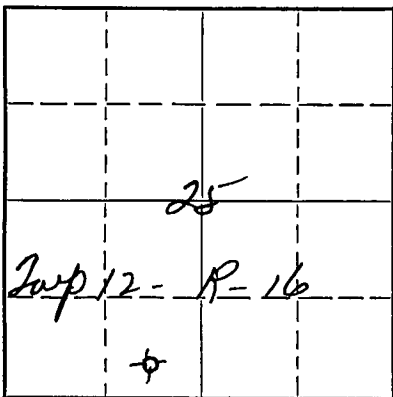

Locate well correctly on above
Section Plat

File Elits County. Sec. 25 Twp 12S Rge 16W (E) (W)
Location as "NE/CNW/SW" or footage from lines G-SE SW SE
Lease Owner Sargent & etal
Lease Name Furthmeyer Well No. 41
Office Address 2548 Mc Bride, Great Bend, Kansas.
Character of Well (completed as Oil, Gas or Dry Hole) Dry Hole
Date well completed 3-23 19 51
Application for plugging filed 3-23 19 51
Application for plugging approved 3-23 19 51
Plugging commenced 3-23 19 51
Plugging completed 3-23 19 51
Reason for abandonment of well or producing formation Dry Hole

If a producing well is abandoned, date of last production 19
Was permission obtained from the Conservation Division or its agents before plugging was commenced? Yes Verbal

Name of Conservation Agent who supervised plugging of this well Eldon Petty
Producing formation Depth to top Bottom Total Depth of Well 3433 Feet
Show depth and thickness of all water, oil and gas formations.

OIL, GAS OR WATER RECORDS

CASING RECORD

Formation	Content	From	To	Size	Put In	Pulled Out
<u>Soil & shale</u>		<u>0</u>	<u>128'</u>	<u>8 5/8"</u>	<u>128'</u>	<u>none</u>
<u>Kansas City</u>		<u>3110'</u>	<u>3357</u>	<u>Dry</u>	<u>none</u>	<u>none</u>
<u>Conglomerate</u>		<u>3384'</u>	<u>3433</u>	<u>Dry</u>	<u>none</u>	<u>none</u>

Describe in detail the manner in which the well was plugged, indicating where the mud fluid was placed and the method or methods used in introducing it into the hole. If cement or other plugs were used, state the character of same and depth placed, from feet to feet for each plug set.

Stirred pits, filled hole with heavy mud. Set bottom wood plug at 125', ran 15 sacks cement through drill pipe. Filled hole with heavy mud to 40'. Placed top wood plug and one sack of Halls at 40'. Ran 10 sacks cement filling hole to bottom of cellar.

(If additional description is necessary, use BACK of this sheet)

Correspondence regarding this well should be addressed to Strain Drilling Co.
Address Box 188 Hays, Kansas.

STATE OF Kansas, COUNTY OF Elits, ss.
T.C. Strain (employee of owner) or (owner or operator) of the above-described well,
being first duly sworn on oath, says: That I have knowledge of the facts, statements, and matters herein contained and the log of the above-described well as filed and that the same are true and correct. So help me God.

(Signature) T.C. Strain

SUBSCRIBED AND SWORN to before me this 27th day of March, 19 51
Box 188, Hays, Kansas.

My commission expires March 1, 1954
Notary Public. Ray R. Power

PLUGGING
FILE SEC 25 T 12 R 16W
BOOK PAGE 70 LINE 4
3-28-1951

WELL LOG

Company: Sargent & etal.

Lease: Furthmeyer

C of - SE - SW SE
Sec. 25 Twp. 12S Rge. 16W
Ellis County, Kansas.

Elevation: 1914 Ground Level

Note: All meas. rotary bushings.

0	5 Gellar
5	90 Brown shale
90	128 Shale & shells
128	550 Shale & shells
550	670 Shale & sand
670	1015 Redbed
1015	1020 Anhydrite
1020	1055 Anhydrite
1055	1155 Shale & shells
1155	1205 Shale & salt
1205	1420 Shale & shells
1420	1645 Shale & lime
1645	1830 Lime & shale
1830	1960 Lime & shale
1960	2020 Lime
2020	2125 Lime & shale
2125	2215 Lime & shale
2215	2375 Shale & lime
2375	2520 Shale & lime
2520	2660 Shale
2660	2805 Shale & lime
2805	2840 Shale & Lime
2840	2885 Lime & shale
2885	2950 Lime
2950	3010 Lime & shale
3010	3065 Lime & shale
3065	3115 Lime & shale
3115	3180 Lime
3180	3225 Lime
3225	3280 Lime
3280	3335 Lime
3335	3359 Lime
3359	3385 Marmaton Lime
3385	3433 Conglomerate
3433	T.D. (rotary bushing meas.)

COMMENCED: 3-13-51

COMPLETED: 3-23-51

CASING RECORD:8 5/8" Surface casing set at
130' w/80 sacks cement by
Globe Cementing Co.No Drill stem test or Electric
logs.TOPS:

Anhydrite	1015
Reebner	3059
Trento	3079
Lansing (K.C.)	3110

Marmaton	3357
Cherty Conglomerate	3384
T.D.	3433

STATE OF KANSAS)
COUNTY OF ELLIS) SS.

I hereby affirm that the above and foregoing is a true and correct
copy of the log of the Furthmeyer #1, located C of - SE - SW SE, Sec. 25
Twp. 12S, Rge. 16W, Ellis County, Kansas.

CONTRACTOR Strain Drilling CompanyB6 T.C. StrainSubscribed and sworn to before me this 27th, day of March, 1951My Commission expires March 1, 1954.**PLUGGING**FILE SEC 25 T 12 R 16W
BOOK PAGE 70 LINE 4

3-28-1951

LeRoy P. Power
NOTARY PUBLIC