


STATE OF KANSAS  
STATE CORPORATION COMMISSION15-051-23294-00-00  
WELL PLUGGING RECORD

Give All Information Completely  
Make Required Affidavit  
Mail or Deliver Report to  
Conservation Division  
State Corporation Comm.  
245 North Water  
Wichita, KS 67202

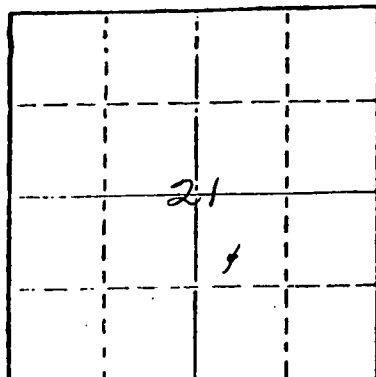

Locate well correctly on above  
Section Plat

ELLIS County. Sec. 21 Twp. 125 Rge. 16 E/W  
Location as "NE/CNW $\frac{1}{4}$ SW $\frac{1}{4}$ " or footage from lines

SE NW SE  
Lease Owner PETROP INTERNATIONAL INC.  
Lease Name CHRISLER Well No. 1

Office Address 7030 S. YALE, TULSA, OK.  
Character of Well (Completed as Oil, Gas or Dry Hole)  
DRY HOLE

Date Well completed 1-2 1983  
Application for plugging filed 1-2 (VERBAL) 1983  
Application for plugging approved 1-2 (VERBAL) 19  
Plugging commenced 1-2-83 19  
Plugging completed 1-2-83 19  
Reason for abandonment of well or producing formation

DRY HOLE  
If a producing well is abandoned, date of last production  
NA 19

Was permission obtained from the Conservation Division or  
its agents before plugging was commenced? YES

Name of Conservation Agent who supervised plugging of this well DENNIS HAMEL  
Producing formation Depth to top Bottom Total Depth of Well 529  
Show depth and thickness of all water, oil and gas formations.

## OIL, GAS OR WATER RECORDS

## CASING RECORD

FORMATION	CONTENT	FROM	TO	SIZE	PUT IN	PULLED OUT

Describe in detail the manner in which the well was plugged, indicating where the mud fluid was placed and the method or methods used in introducing it into the hold. If cement or other plugs were used, state the character of same and depth placed, from feet to feet for each plug set.

20 SACKS 1200 - 1129  
100 SACKS 800 - 445  
40 SACKS 270 - 130  
10 SACKS 40 - 0  
10 SACKS RAT HOLE

180 SACKS 50/50 POFMIX WITH 6% GEL 1 PLUG AT 40'

(If additional description is necessary, use BACK of this sheet)

Name of Plugging Contractor ALLIED CEMENTING COMPANY INC. P. O. BOX 31 RUSSELL KANSAS 67665

STATE OF OKLAHOMA COUNTY OF TULSA, ss.  
R. W. COBURN (employee of owner) or (owner or operator)  
of the above-described well, being first duly sworn on oath, says: That I have knowledge of the facts, statements, and matters herein contained and the log of the above-described well as filed and that the same are true and correct. So help me God.

(Signature) R. W. Coburn  
7030 S. YALE, TULSA, OKLA. 74177  
(Address)

SUBSCRIBED AND SWORN TO before me this 11 day of JANUARY, 19 83

My commission expires 3-14-84

Sara Ann Tucker  
Notary Public.