


STATE OF KANSAS  
STATE CORPORATION COMMISSION

Give All Information Completely  
Make Required Affidavit  
Mail or Deliver Report to:  
Conservation Division  
State Corporation Commission  
212 North Market, Insurance Bldg.  
Wichita, Kansas

15-051-21371-00-00  
WELL PLUGGING RECORD

Ellis County, Sec. 23<sup>1/2</sup> Twp. 12S Rge. 16W (E) (W)

Location as "NE/CNWxSWx" or footage from lines SW SW NE  
Lease Owner John O. Farmer, Inc.  
Lease Name CHRISLER Well No. 1  
Office Address Box 352, Russell, Kansas 67665  
Character of Well (completed as Oil, Gas or Dry Hole) Dry Hole  
Date well completed 9-30-77 19  
Application for plugging filed Yes 19  
Application for plugging approved 19  
Plugging commenced 19  
Plugging completed 9:45 P.M., 9-30-77 19  
Reason for abandonment of well or producing formation

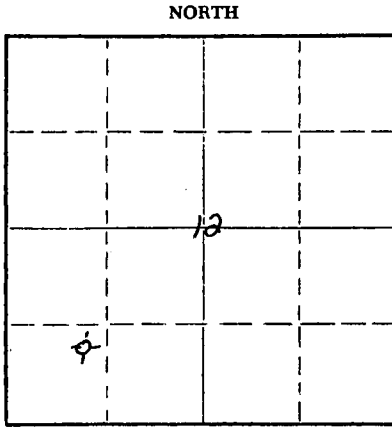

Locate well correctly on above Section Plat

If a producing well is abandoned, date of last production 19  
Was permission obtained from the Conservation Division or its agents before plugging was commenced? Yes

Name of Conservation Agent who supervised plugging of this well Leo Massey  
Producing formation \_\_\_\_\_ Depth to top \_\_\_\_\_ Bottom \_\_\_\_\_ Total Depth of Well \_\_\_\_\_ Feet  
Show depth and thickness of all water, oil and gas formations.

OIL, GAS OR WATER RECORDS

CASING RECORD

FORMATION	CONTENT	FROM	TO	SIZE	PUT IN	PULLED OUT

Describe in detail the manner in which the well was plugged, indicating where the mud fluid was placed and the method or methods used in introducing it into the hole. If cement or other plugs were used, state the character of same and depth placed, from \_\_\_\_\_ feet to \_\_\_\_\_ feet for each plug set.

Plug #1	550'	50 sx.
Plug #2	215'	25 sx.
Plug #3	50'	10 sx.

RECEIVED  
STATE CORPORATION COMMISSION  
10-4-1977  
OCT 04 1977  
CONSERVATION DIVISION  
WICHITA, KANSAS

(If additional description is necessary, use BACK of this sheet)  
Name of Plugging Contractor John O. Farmer, Inc.  
Address Box 352, Russell, Kansas 67665

STATE OF KANSAS, COUNTY OF RUSSELL, ss.  
John O. Farmer (employee of owner) or (owner or operator) of the above-described well, being first duly sworn on oath, says: That I have knowledge of the facts, statements, and matters herein contained and the log of the above-described well as filed and that the same are true and correct. So help me God.

(Signature) John O. Farmer  
Box 352, Russell, Kansas 67665 (Address)

SUBSCRIBED AND SWORN TO before me this 3rd day of October, 1977



Helen Carlson  
Notary Public.

**KANSAS DRILLERS LOG**

15-051-21371-00-00

API No. 15 \_\_\_\_\_  
 County \_\_\_\_\_ Number \_\_\_\_\_

Operator  
 John O. Farmer, Inc.

Address  
 Box 352, Russell, Kansas 67665

Well No. 1 Lease Name CHRISLER


Footage Location  
 990 feet from (X) (S) line 990 feet from (X) (W) line

Principal Contractor John O. Farmer, Inc. Geologist Sam Farmer

Spud Date 9-23-77 Total Depth 3480 P.B.T.D.

Date Completed 9-30-77 Oil Purchaser None -- D & A

S. 21 T. 12S R. 16W E  
 Loc. SW SW NE  
 County Ellis

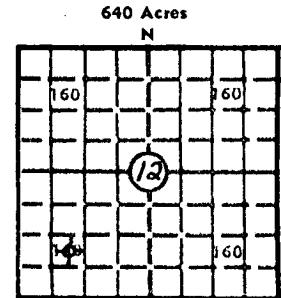

Locate well correctly  
 Elev.: Gr. 1959  
 DF 1962 KB 1964

**CASING RECORD**

Report of all strings set — surface, intermediate, production, etc.

Purpose of string	Size hole drilled	Size casing set (in O.D.)	Weight lbs/ft.	Setting depth	Type cement	Sacks	Type and percent additives
Surface	12 1/4	8-5/8	26	216	Common	140	

**LINER RECORD**

**PERFORATION RECORD**

Top, ft.	Bottom, ft.	Sacks cement	Shots per ft.	Size & type	Depth interval

Size	Setting depth	Packer set at

**ACID, FRACTURE, SHOT, CEMENT SQUEEZE RECORD**

Amount and kind of material used	Depth interval treated

STATE CORP. COM. STAMP  
 OCT 04 1977  
 10-4-1977  
 CONSERVATION DIVISION  
 WICHITA, KANSAS

**INITIAL PRODUCTION**

Date of first production	Producing method (flowing, pumping, gas lift, etc.)				
<b>RATE OF PRODUCTION PER 24 HOURS</b>	Oil	Gas	Water	Gas-oil ratio	
	bbis.	MCF	bbis.	CFPB	
Disposition of gas (vented, used on lease or sold)			Producing interval (s)		

INSTRUCTIONS: As provided in KCC Rule 82-2-125, within 90 days after completion of a well, one completed copy of this Drillers Log shall be transmitted to the State Geological Survey of Kansas, 4150 Monroe Street, Wichita, Kansas 67209. Copies of this form are available from the Conservation Division, State Corporation Commission, 3830 So. Meridian (P.O. Box 17027), Wichita, Kansas 66217. Phone AC 316-522-2206. If confidential custody is desired, please note Rule 82-2-125. Drillers Logs will be on open file in the Oil and Gas Division, State Geological Survey of Kansas, Lawrence, Kansas 66044.

DESIGNATE TYPE OF COMP.: OIL, GAS, DRY HOLE, SWDW, ETC.:

Operator  
John O. Farmer, Inc.

Well No. 1 Lease Name CHRISLER

Dry Hole

S 12 T 12 S R 16 W E W

**WELL LOG**

Show all important zones of porosity and contents thereof; cored intervals, and all drill-stem tests, including depth interval tested, cushion used, time tool open, flowing and shut-in pressures, and recoveries.

SHOW GEOLOGICAL MARKERS, LOGS RUN, OR OTHER DESCRIPTIVE INFORMATION.

FORMATION DESCRIPTION, CONTENTS, ETC.	TOP	BOTTOM	NAME	DEPTH
Shale	220	450	Sample Tops	
Shale & Sand	450	560		
Hard Sand & Pyrite	560	575	Anhydrite	1113 (+ 851)
Pyrite	575	590	Heebner	3134 (-1170)
Shale & Shells	590	605	Toronto	3156 (-1192)
Sand	605	730	Lansing	3184 (-1220)
Shale & Shells	730	1113	Arbuckle	3447 (-1483)
Anhydrite	1113	1152	T.D.	3480 (-1516)
Shale & Shells	1152	1873		
Shale & Lime	1873	2190		
Lime & Shale	2190	2610		
Shale & Lime	2610	2905		
Lime & Shale	2905	3195		
Lime	3195	3447		
Arbuckle	3447	3480		

DST #1 3190-3235  
 Tool Open 30-30-60-60; weak blow  
 70 min.  
 Rec: 60' oil cut mud (10% oil)  
 IFP: 42-52 FFP: 52-63  
 BHP: 707-696

DST #2 3449-3459  
 Tool Open 30-30-30-30; weak blow  
 25 min.  
 Rec: 20' mud  
 IFP: 21-21  
 BHP: 74

USE ADDITIONAL SHEETS, IF NECESSARY, TO COMPLETE WELL RECORD.

Date Received

*John O. Farmer*  
 Signature  
 President

October 3, 1977  
 Title  
 Date