


STATE OF KANSAS
STATE CORPORATION COMMISSION

Give All Information Completely
Make Required Affidavit
Mail or Deliver Report to:
Conservation Division
State Corporation Commission
212 No. Market
Wichita, Kansas

Form CP-4

15-051-20484-00-00
WELL PLUGGING RECORD

NORTH

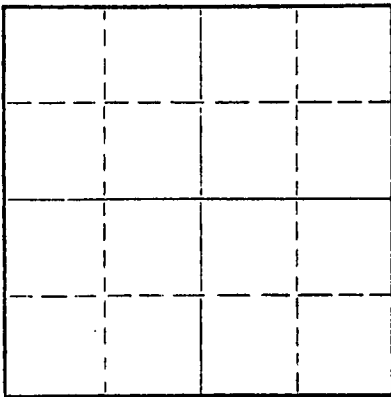

Locate well correctly on above
Section Plat

Ellis County, Sec. 21 Twp. 12 Rge. (E) 16 (W)
Location as "NE/CNWxSWx" or footage from lines C S/2 N/2 SE
Lease Owner Paramount Petroleum Co.
Lease Name Chrisler Well No. 1
Office Address 5900 East Central Suite 102
Character of Well (completed as Oil, Gas or Dry Hole) Dry Hole
Date well completed Aug. 28 19 69
Application for plugging filed Aug. 28 19 69
Application for plugging approved Aug. 28 19 69
Plugging commenced Aug. 28 19 69
Plugging completed Aug. 28 19 69
Reason for abandonment of well or producing formation Dry Hole

If a producing well is abandoned, date of last production 19
Was permission obtained from the Conservation Division or its agents before plugging was commenced? Yes

Name of Conservation Agent who supervised plugging of this well Leo Massey
Producing formation Depth to top Bottom Total Depth of Well 3500 Feet
Show depth and thickness of all water, oil and gas formations.

OIL, GAS OR WATER RECORDS

CASING RECORD

FORMATION	CONTENT	FROM	TO	SIZE	PUT IN	PULLED OUT
				8 5/8	197'	

Describe in detail the manner in which the well was plugged, indicating where the mud fluid was placed and the method or methods used in introducing it into the hole. If cement or other plugs were used, state the character of same and depth placed, from feet to feet for each plug set.

Bottom plug @ 600' with 70 sx.
Middle plug @ 180' with 20 sx.
Top plug @ 40' with 10 sx.

RECEIVED
STATE CORPORATION COMMISSION
SEP 22 1969
CONSERVATION DIVISION
Wichita, Kansas

(If additional description is necessary, use BACK of this sheet)

Name of Plugging Contractor Woodman & Iannitti Drilling Co.
Address 706 Union National Bldg.

STATE OF KANSAS, COUNTY OF SEDGWICK, ss.
K. T. Woodman (employee of owner) or (owner or operator) of the above-described well, being first duly sworn on oath, says: That I have knowledge of the facts, statements, and matters herein contained and the log of the above-described well as filed and that the same are true and correct. So help me God.

(Signature) K. T. Woodman

706 Union National Bldg.
(Address)

SUBSCRIBED AND SWORN TO before me this 29th day of August, 19 69

My commission expires Feb. 11, 1972

Justina Chamberlain
Notary Public.

Company:

15-051-20484-00-00
Paramount Petroleum Co.

Farm:

Chrisler No. 1

Section:

21-12-16W

Location:

C S/2 N/2 SE

County:

Ellis

Total Depth

3500'

Comm:

August 21, 1969

Comp:

August 28, 1969

Contractor:

Woodman & Iannitti Drilling Co.

Casing:

8 5/8" @ 197' w/130 sx.

Figures Indicate Bottom Of Formations

45	Clay & Shale
198	Shale
300	Shale
520	Red Bed
630	Sand
800	Red Bed, Shale & Sand
1100	Red Bed
1139	Red Bed
1176	Anhy
1660	Shale & Shells
1790	Shale & Shells
1900	Lime & Shale
2110	Lime & Shale
2225	Lime
2465	Lime & Shale
2605	Lime
2805	Lime
2945	Lime
3014	Lime
3090	Lime
3185	Lime
3260	Lime
3275	Lime
3340	Lime
3397	Lime
3460	Lime
3500	Lime

RECEIVED
STATE CORPORATION COMMISSION
SEP 2 1969
CONSERVATION DIVISION
Wichita, Kansas

I certify the above to be a true and correct copy of the driller's log and the geological tops to the best of my knowledge and belief.

Woodman & Iannitti Drilling Co.

K. T. Woodman
K. T. Woodman