


Give All Information Completely
Make Required Affidavit
Mail or Deliver Report to:
Conservation Division
State Corporation Commission
211 No. Broadway
Wichita, Kansas

15-051-30295-00-00
WELL PLUGGING RECORD

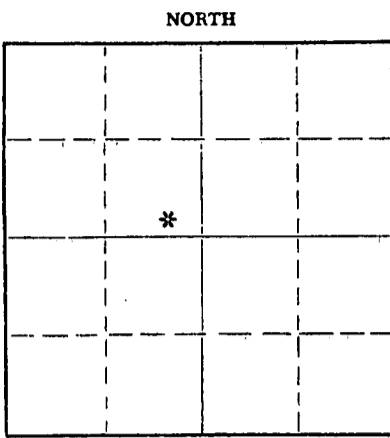

Locate well correctly on above Section Plat

Location as "NE/CNW&SW" or footage from lines Ellis County. Sec. 29 Twp. 12 Rge. 16 (E) W (W)
SE SE NW
Lease Owner Solar Oil Company
Lease Name Miller Well No. 1
Office Address 1117 Union National Building Wichita, Kansas
Character of Well (completed as Oil, Gas or Dry Hole) Dry Hole
Date well completed May 20 19 66
Application for plugging filed May 20 19 66
Application for plugging approved May 20 19 66
Plugging commenced May 20 19 66
Plugging completed May 20 19 66
Reason for abandonment of well or producing formation Dry hole

If a producing well is abandoned, date of last production _____ 19____
Was permission obtained from the Conservation Division or its agents before plugging was commenced? Yes

Name of Conservation Agent who supervised plugging of this well Mr. Massey Hays, Kansas
Producing formation _____ Depth to top _____ Bottom _____ Total Depth of Well 3630 Feet
Show depth and thickness of all water, oil and gas formations.

OIL, GAS OR WATER RECORDS

CASING RECORD

FORMATION	CONTENT	FROM	TO	SIZE	PUT IN	PULLED OUT
Surface Pipe		0	212	8 5/8"	212'	None

Describe in detail the manner in which the well was plugged, indicating where the mud fluid was placed and the method or methods used in introducing it into the hole. If cement or other plugs were used, state the character of same and depth placed, from _____ feet to _____ feet for each plug set.

Pumped 25 sacks cement through drill pipe at 950'
Pumped 10 sacks cement through drill pipe at 210'
10 sacks at 40'
2 sacks in rat hole

RECEIVED
STATE CORPORATION COMMISSION
6-10-1966
MAY 10 1966
COA - STATE CORPORATION COMMISSION
WICHITA, KANSAS

(If additional description is necessary, use BACK of this sheet)
Name of Plugging Contractor Sun Oilwell Cementing, Inc.
Address Box 169 Great Bend, Kansas

STATE OF Kansas, COUNTY OF Barton, ss.
T. D. Sweetman (employee of owner) or (owner) of the above-described well, being first duly sworn on oath, says: That I have knowledge of the facts, statements, and matters herein contained and the log of the above-described well as filed and that the same are true and correct. So help me God.

(Signature) T. D. Sweetman
Box 645 Great Bend, Kansas
(Address)

SUBSCRIBED AND SWORN TO before me this 21th day of May, 1966

My commission expires 5/9/67

Karla L. Boyd
Notary Public.

15-051-30295-00-00

WELL LOG

Miller #1
SE SE NW 29-12S-16W
Ellis County, Kansas

0	40	Clay and rock	Elevation:	2090' K.B.
40	620	Shale and shells		
620	690	Sand and iron	Formation Tops:	
690	695	Shale and sand	Heebner	3274
695	1258	Red bed	Lansing K. C.	3324
1258	1300	Anhydrite	Base K. C.	3560
1300	1550	Shale	Arbuckle	3608
1550	1925	Shale and shells		
1925	3260	Shale and lime		
3260	3630	Lime		
3630		Total Depth		

RECORDED
6-10-1966
DEPT. OF REVENUE
KANSAS

STATE OF KANSAS

COUNTY OF BARTON ss

T. D. Sweetman, Partner of S & S Drilling Company, being first duly sworn on oath says: That I have knowledge of the facts, statements and matters herein contained and the log of the above described well as filed and that the same are true and correct.

T. D. Sweetman

Subscribed and sworn before me this 24th day of May, 1966.

Keith S. Boyd
Notary Public Barton County

My Commission Expires: 5/9/67