


15-163-19058-0000

Give All Information Completely
Make Required Affidavit
Mail or Deliver Report to:
Conservation Division
State Corporation Commission
211 No. Broadway
Wichita, Kansas

WELL PLUGGING RECORD

NORTH

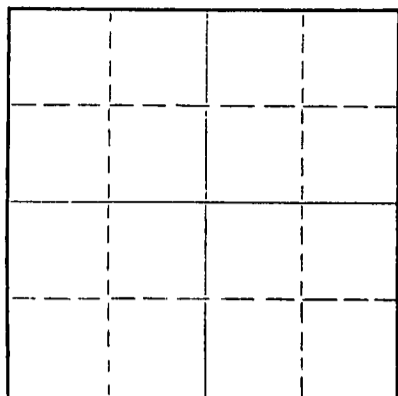

Locate well correctly on above
Section Plat

Rooks County. Sec. 12 Twp. 10 Rge. (E) 20 (W)
Location as "NE/CNW&SW" or footage from lines N/2 SW NE
Lease Owner Sohio Petroleum Company
Lease Name Desbien Well No. 4
Office Address Russell, Kansas
Character of Well (completed as Oil, Gas or Dry Hole) oil
Date well completed 1-17 19 51
Application for plugging filed 10-14 19 58
Application for plugging approved 10-15 19 58
Plugging commenced 11-26 19 58
Plugging completed 11-26 19 58
Reason for abandonment of well or producing formation Uneconomical

If a producing well is abandoned, date of last production February 19 58
Was permission obtained from the Conservation Division or its agents before plugging was commenced? Yes

Name of Conservation Agent who supervised plugging of this well Eldon Petty
Producing formation Arbuckle Depth to top _____ Bottom _____ Total Depth of Well 3789 Feet
Show depth and thickness of all water, oil and gas formations.

OIL, GAS OR WATER RECORDS

CASING RECORD

FORMATION	CONTENT	FROM	TO	SIZE	PUT IN	PULLED OUT
				5-1/2	3786'	None
				8-5/8	392	None

Describe in detail the manner in which the well was plugged, indicating where the mud fluid was placed and the method or methods used in introducing it into the hole. If cement or other plugs were used, state the character of same and depth placed, from _____ feet to _____ feet for each plug set.

~~54 casing cemented to surface. Pumped 10 sacks of Jet
followed by 80 sacks of common cement down casing.~~

RECEIVED
STATE CORPORATION COMMISSION
12-8-58
DEC 8 - 1958
CONSERVATION DIVISION
Wichita

(If additional description is necessary, use BACK of this sheet)

Name of Plugging Contractor Sohio Petroleum Company
Address Russell, Kansas

STATE OF Kansas, COUNTY OF Russell, ss.
J. H. Bond (employee of owner) of the above-described well, being first duly sworn on oath, says: That I have knowledge of the facts, statements, and matters herein contained and the log of the above-described well as filed and that the same are true and correct. So help me God.

(Signature) J. H. Bond

SUBSCRIBED AND SWORN TO before me this 5 day of December, 19 58

My commission expires July 2, 1961 Russell W. Miller Notary Public.

PLUGGING
FILE SEC. 12 T. 10 R. 4W
BOOK PAGE 136 LINE 26

Deeple Well No. 4

Contractor: The R. W. Rice Drilling Company
 Started 12/1/53 Finished 12/24/53

LOG

Sand, Clay & Shells	0	=	392	
Shale	392	=	850	Sy @ 2000 = 1
Shale, Shells, Clay	850	=	1435	Sy @ 1700 = 1
Shell, Shale	1435	=	1833	Sy @ 1500 = 1
Anhydrite	1833	=	1875	
Red Bed, Shale, Shells	1875	=	1950	
Shale & Lime	1950	=	2175	Sy @ 2200 = 1
Shale & Lime	2175	=	2520	
Lime	2520	=	2800	
Broken Lime	2800	=	2900	
Shale & Lime	2900	=	3415	Sy @ 3000 = C.V.
Lime	3415	=	3761	
Conglomerate	3761	=	3783	T.L.

Tops: Hoobner	3446
Lansing	3434
Arbuckle	3736
T.D.	3783

State of Kansas)
 County of Sedgwick) ss.

I, E. H. Slyor, do hereby certify that the above is a true and accurate log of the Deacon Well No. 4, located in C/1/2 SW NE of Section 12-11S-20W, Ross County, Kansas.

Secretary

Subscribed to and sworn before me this 30th day of December, 1953

My Commission Expires September 18, 1958

PLUGGING			
FILE	SEC 12	T. 10	R. 4W
BOOK	PAGE 136	LINE	26

RECORDED
 COMMISSION
 OCT 15 1958
 CONSERVATION DIVISION
 WICHITA, KANSAS