

STATE OF KANSAS  
 STATE CORPORATION COMMISSION  
 200 Colorado Derby Building  
 Wichita, Kansas 67202

WELL PLUGGING RECORD  
 K.A.R.-82-3-117

API NUMBER 15-163-020701 <sup>02071-0000</sup>

LEASE NAME E. Sutor

WELL NUMBER #1

330 Ft. from S Section Line

330 Ft. from E Section Line

SEC. 12 TWP. 10 RGE. 20 (E) or (W)

COUNTY Rooks

Date Well Completed 1/18/50

Plugging Commenced 12/29/89

Plugging Completed 12/30/89

TYPE OR PRINT  
 NOTICE: Fill out completely  
 and return to Cons. Div.  
 office within 30 days.

LEASE OPERATOR BP Exploration

ADDRESS 9401 SW Fwy, Houston, TX 77074

PHONE # (713) 272-5000 OPERATORS LICENSE NO. 06854

Character of Well Oil

(Oil, Gas, D&A, SWD, Input, Water Supply Well)

The plugging proposal was approved on 12/23/89 (date)

by Dennis Hamel (KCC District Agent's Name).

Is ACO-1 filed? Yes If not, Is well log attached? \_\_\_\_\_

Producing Formation L-KC Depth to Top 3458 Bottom 3773 T.D. 3776

PBTD 3748

Show depth and thickness of all water, oil and gas formations.

OIL, GAS OR WATER RECORDS

CASING RECORD

2-5-96

Formation	Content	From	To	Size	Put In	Pulled out
L-KC	Oil (3458-3773)	0	1659	8 5/8"	1659	5'
Arbuckle	Oil (3773-NDE)	0	3774	5 1/2"	3774	5'

FEB 5 1990

Describe in detail the manner in which the well was plugged, indicating where the mud fluid was placed and the method or methods used in introducing it into the hole. If cement or other plugs were used, state the character of same and depth placed, from \_\_\_ feet to \_\_\_ feet each set.

Set EZSV @ 3450' Pumped 85 sks cmt below and dumped 100' cmt on top. Circulated gel to 1700'  
 Perf'd @ 1664 & circulated 120 sks cmt to surface. Pumped 145 sks down hole. TOC @ 524'  
 Perf'd @ 500' & 300' circulated 100 sks cmt to surface. Pumped another 15 sks down hole.  
 Cement was 65/35 POZ w/ 10% gel & 2% CaCl

(If additional description is necessary, use BACK of this form.)

Name of Plugging Contractor Halliburton License No. 5287

Address 1100 E. 8th, Hays, Kansas


NAME OF PARTY RESPONSIBLE FOR PLUGGING FEES: BP Exploration

STATE OF Texas COUNTY OF Harris, ss.

Scott Marshall (Employee of Operator) or (Operator) of above-described well, being first duly sworn on oath, says: That I have knowledge of the facts, statements, and matters herein contained and the log of the above-described well as filed that the same are true and correct, so help me God.

(Signature) Scott Marshall

(Address) 9401 SW Fwy, Houston, TX 77074

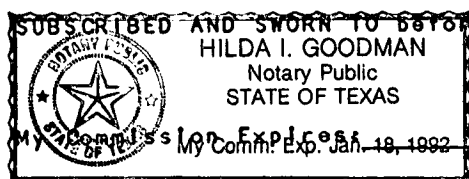

me this 31st day of January, 19 90  
Hilda I. Goodman  
 Notary Public


ROOKS COUNTY  
SEC 12 T10S R20W  
SE-SE

15-163-02071-0000  
BERLAND (MARCOTTE)

EARL SUTOR #1

SPUD: 11/18/49

CURRENT STATUS:  
ABANDONED

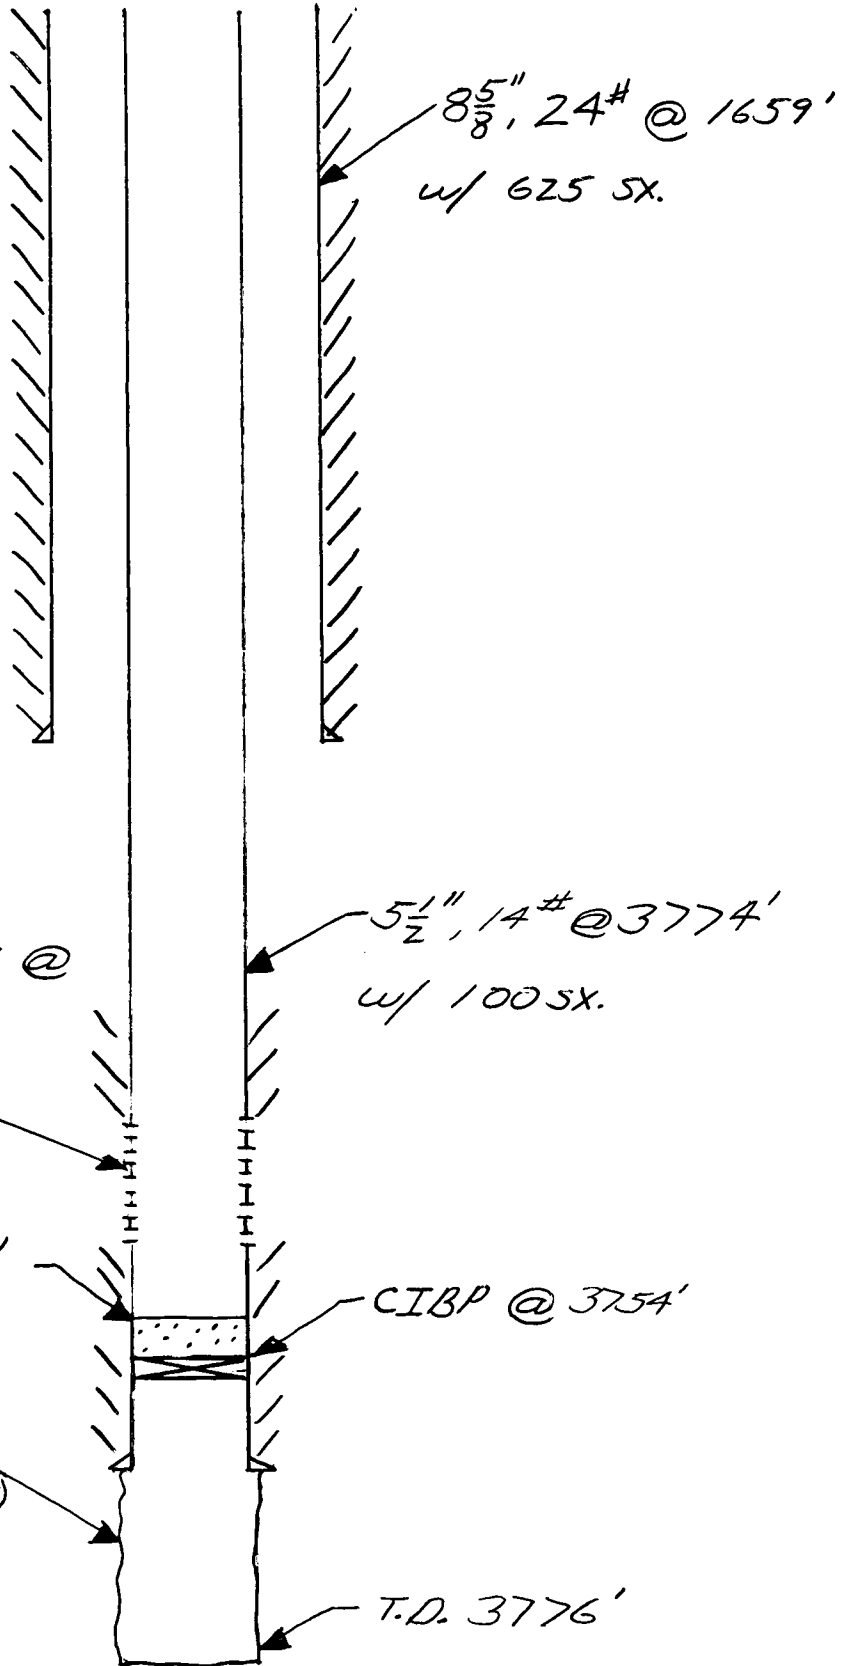

LANPING-K.C. PERFS @  
3522'-26'  
3564'-72'  
3603'-07'  
3637'-41'  
3659'-63'  
3675'-79'

PBTD @ 3749'  
w/ 1 SX.

5 1/2", 14# @ 3774'  
w/ 100 SX.

CIBP @ 3754'

3774'-3776'  
ARBUCKLE (OH)

T.D. 3776'

RECEIVED  
STATE CORPORATE COMMISSION

NOV 15 1969

CONSERVATION DIVISION  
Wichita, Kansas