

15-163-03084-0000


STATE OF KANSAS  
STATE CORPORATION COMMISSION

WELL PLUGGING RECORD

Give All Information Completely  
Make Required Affidavit  
Mail or Deliver Report to:  
Conservation Division  
State Corporation Commission  
211 No. Broadway  
Wichita, Kansas

Rooks County, Sec. 12 Twp. 10 Rge. (E) 20(W)

Location as "NE/CNW&SW" or footage from lines NW NW SW  
Lease Owner Sohio Petroleum Company  
Lease Name Sutor B Well No. 8  
Office Address Russell, Kansas  
Character of Well (completed as Oil, Gas or Dry Hole) Dry  
Date well completed 12-23 19 56  
Application for plugging filed 12-23 19 56  
Application for plugging approved 12-27 19 56  
Plugging commenced 12-23 19 56  
Plugging completed 12-23 19 56  
Reason for abandonment of well or producing formation Dry

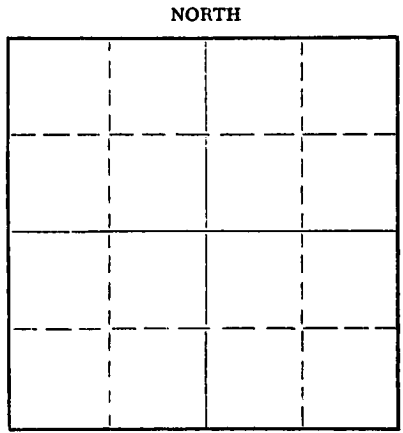

Locate well correctly on above  
Section Plat

If a producing well is abandoned, date of last production \_\_\_\_\_ 19 \_\_\_\_\_  
Was permission obtained from the Conservation Division or its agents before plugging was commenced? Yes

Name of Conservation Agent who supervised plugging of this well Eldon Petty  
Producing formation \_\_\_\_\_ Depth to top \_\_\_\_\_ Bottom \_\_\_\_\_ Total Depth of Well 3830 Feet  
Show depth and thickness of all water, oil and gas formations.

OIL, GAS OR WATER RECORDS

CASING RECORD

FORMATION	CONTENT	FROM	TO	SIZE	PUT IN	PULLED OUT
				8-5/8	1659'	None

Describe in detail the manner in which the well was plugged, indicating where the mud fluid was placed and the method or methods used in introducing it into the hole. If cement or other plugs were used, state the character of same and depth placed, from \_\_\_\_\_ feet to \_\_\_\_\_ feet for each plug set.

3830' to 300' - Heavy Mud  
300' to 40' - Halliburton Plug, 1/2 Sack Hulls, 15 Sacks Cement  
40' to Cellar - Halliburton Plug, 1/2 Sack Hulls, 10 Sacks Cement

(If additional description is necessary, use BACK of this sheet)

Name of Plugging Contractor Reserve Drilling Company  
Address Wichita, Kansas

STATE OF Kansas, COUNTY OF Russell, ss.  
\_\_\_\_\_, (employee of owner) ~~and owner or operator~~ of the above-described well, being first duly sworn on oath, says: That I have knowledge of the facts, statements, and matters herein contained and the log of the above-described well as filed and that the same are true and correct. So help me God.

(Signature) J. H. Bond  
(Address) \_\_\_\_\_

SUBSCRIBED AND SWORN TO before me this 26th day of December, 19 56

January 24, 1959

Benedict Robinson  
Notary Public.

My commission expires \_\_\_\_\_

PLUGGING  
FILE SEC 12 T 10 R 26 W  
BOOK PAGE 128 LI E 36

STATE OF KANSAS  
12-26-56  
CONS

15-163-03084-0000

WELL LOG

SOHIO PETROLEUM COMPANY

SUTOR "B" 8

NW NW SW 12-10-20W  
Rooks County, Kansas

Comm: 12- 9-56

Comp: 12-23-56

Casing: 8-5/8" 1662' w/800 sax

Formations

Depth

Shale	240
Shale and shells	845
Sand	1030
Sand and shale	1295
Shale and shells	1610
Red bed	1650
Anhydrite	1690
Shale and shells	2150
Lime and shale	2925
Shale	3100
Shale and shells	3250
Lime	3765
Conglomerate	3773
Lime	3805
Shale	3815
Arbuckle	3820
Lime	3830

STATE OF KANSAS }  
COUNTY OF SEDGWICK } SS:

L. C. Hay, of lawful age states that the formations and depths herein are correct to his best knowledge and belief.

L. C. Hay  
L. C. Hay

Subscribed and sworn to before me this 28th day of December, 1956.

Nola Babb  
Nola Babb, Notary Public

My commission expires Nov. 3, 1960

PLUGGING  
TWP. 12T. 10R. 20W  
BOOK PAGE 128 LINE 36