


Give All Information Completely  
Make Required Affidavit  
Mail or Deliver Report to:  
Conservation Division  
State Corporation Commission  
211 No. Broadway  
Wichita, Kansas

WELL PLUGGING RECORD

NORTH

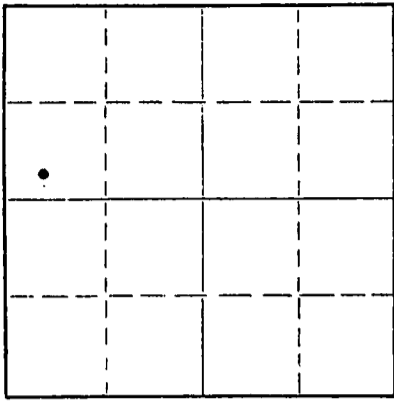

Locate well correctly on above Section Plat

Rooks County. Sec. 12 Twp. 10S Rge. (E) 20 (W)  
Location as "NE/CNW&SW&" or footage from lines SW/4 SW/4 NW/4  
Lease Owner Continental Oil Company  
Lease Name C. A. Desbien Well No. 8  
Office Address Drawer 98 Plainville, Kansas  
Character of Well (completed as Oil, Gas or Dry Hole) Dry Hole  
Date well completed December 18, 1956  
Application for plugging filed December 18, 1956  
Application for plugging approved December 18, 1956  
Plugging commenced December 18, 1956  
Plugging completed December 18, 1956  
Reason for abandonment of well or producing formation No commerical zones encountered  
If a producing well is abandoned, date of last production \_\_\_\_\_ 19\_\_\_\_  
Was permission obtained from the Conservation Division or its agents before plugging was commenced? Yes

Name of Conservation Agent who supervised plugging of this well Mr. Eldon Petty  
Producing formation None Depth to top \_\_\_\_\_ Bottom \_\_\_\_\_ Total Depth of Well 3,850 Feet  
Show depth and thickness of all water, oil and gas formations.

OIL, GAS OR WATER RECORDS

CASING RECORD

FORMATION	CONTENT	FROM	TO	SIZE	PUT IN	PULLED OUT
				8 5/8"	245'	None

Describe in detail the manner in which the well was plugged, indicating where the mud fluid was placed and the method or methods used in introducing it into the hole. If cement or other plugs were used, state the character of same and depth placed, from \_\_\_\_\_ feet to \_\_\_\_\_ feet for each plug set.

Filled hole to 245 feet with mud. Set plug and put in 1/2 sack hulls. Cement thru drill pipe with 15 sacks. Filled hole with mud to 40 feet. Set plug and put in 1/2 sack hulls. Cemented thru drill pipe to surface. Used Globe Oil Well Cementing Company to plug.

RECEIVED  
STATE CORP. COM. DIVISION  
DEC 21 1956  
WICHITA, KANSAS

(If additional description is necessary, use BACK of this sheet)

Name of Plugging Contractor Peel Brothers, Incorporated  
Address Box 88 Hoisington, Kansas

STATE OF Kansas, COUNTY OF Rooks, ss.  
L. E. Powell (employee of owner) or (owner or operator) of the above-described well, being first duly sworn on oath, says: That I have knowledge of the facts, statements, and matters herein contained and the log of the above-described well as filed and that the same are true and correct. So help me God.

(Signature) L. E. Powell  
Drawer 98 Plainville, Kansas  
(Address)

SUBSCRIBED AND SWORN TO before me this 19th day of December, 19 56

Kenneth J. Terry  
Notary Public.

My commission expires December 2, 1957  
RGW  
12-19-56  
State Corp. Comm. RFD File

PLUGGING  
FILE SEC 12 T 10 R 20W  
BOOK PAGE 127 LINE 20

15-163-03083-0000

State  
Corp.  
Comm.

DRILLERS' LOG

Company: Continental Oil Company  
Farm Name: Deabien Well No. 8  
Total Depth: 3850'  
Comm: 12/8/56 Comp: 12/18/56  
Contractor: Peel Brothers, Inc.  
Casing: 8 5/8" @ 255' cem.

SW SW NW  
Sec. 12, Twp. 10S, Rge. 20W,  
County: Rooks,  
Kansas  
Elevation:  
Production: Dry

Figures below indicate bottoms of formations:

Surface soils	0 -	257
Blue shale		415
Shale		825
Sand		1300
Shale and shells		1525
Red bed and shale		1662
Anhydrite		1692
Shale		1945
Shale and shells		2210
Lime and shale		2580
Lime		2740
Lime and shale		2865
Lime		2945
Lime and shale		3395
Lime		3702
Lime and shale		3780
Conglomerate		3850
Total Depth		3850

This is to certify that the above information is to the best of our knowledge, true and correct.

PEEL BROTHERS, INC.

BY: Al H. Smith

SUBSCRIBED AND SWORN to before me this 26th day of December, 1956.

My commission expires: April 27, 1960

Ruth Brank  
Notary Public

RECEIVED  
STATE CORPORATION COMMISSION

CONSERVATION DIVISION  
Wichita, Kansas

PLUGGING  
FILE SEC. 12 T. 10 R. 20W  
BOOK PAGE 127 LINE 20