


WELL PLUGGING RECORD

Give All Information Completely
Make Required Affidavit
Mail or Deliver Report to:
Conservation Division
State Corporation Commission
212 No. Market
Wichita, Kansas

Rooks County, Sec. 5 Twp. 10 Rge. (E) 20 (W)
Location as "NE/CNW/SW" or footage from lines SE NW NW
Lease Owner The Bovaird Supply Company
Lease Name Renner Well No. 3
Office Address P.O. Box 2590, Tulsa, Oklahoma
Character of Well (completed as Oil, Gas or Dry Hole) oil
Date well completed 19
Application for plugging filed July 14 19 69
Application for plugging approved 19
Plugging commenced September 8 19 69
Plugging completed September 9 19 69
Reason for abandonment of well or producing formation depleted

NORTH

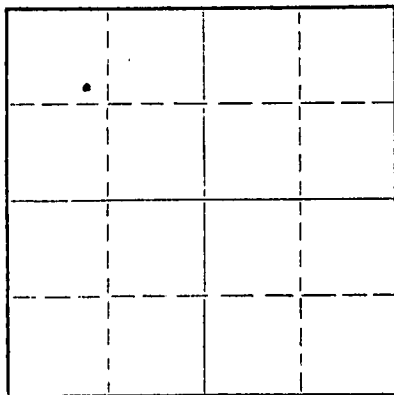

Locate well correctly on above Section Plat

If a producing well is abandoned, date of last production 19
Was permission obtained from the Conservation Division or its agents before plugging was commenced? yes

Name of Conservation Agent who supervised plugging of this well Leo Massey
Producing formation Depth to top Bottom Total Depth of Well 3846 Feet
Show depth and thickness of all water, oil and gas formations.

OIL, GAS OR WATER RECORDS

CASING RECORD

FORMATION	CONTENT	FROM	TO	SIZE	PUT IN	PULLED OUT
		0	159'	8 5/8"	159'	none
		0	3835'	5 1/2"	3835'	167'

Describe in detail the manner in which the well was plugged, indicating where the mud fluid was placed and the method or methods used in introducing it into the hole. If cement or other plugs were used, state the character of same and depth placed, from feet to feet for each plug set.

Sanded back from 3846' to 3820'. Ran 5 sacks of cement from 3820' to 3790'.
Filled hole with mud from 3780' to 700'; set rock bridge from 700' to 685'. Ran 4 yards of ready mix cement from 685' to base of cellar.

RECEIVED
STATE CORPORATION COMMISSION
10-16-69
OCT 16 1969
CONSERVATION DIVISION
Wichita, Kansas

Name of Plugging Contractor PIPE PULLERS, INC.
Address Box 486, Ellinwood, Kansas

STATE OF Kansas, COUNTY OF Barton, ss.
Evelyn Roth (employee of owner) or (owner or operator) of the above-described well, being first duly sworn on oath, says: That I have knowledge of the facts, statements, and matters herein contained and the log of the above-described well as filed and that the same are true and correct. So help me God.

(Signature) Evelyn Roth
Ellinwood, Kansas
(Address)

SUBSCRIBED AND SWORN TO before me this 25th day of September, 1969

My commission expires Feb. 10, 1971
George A. Meyer Notary Public.

15-163-03145-0000

WELL LOG BUREAU - KANSAS GEOLOGICAL SOCIETY
412 Union National Bk. Bldg. Wichita, Kansas


COPY

Company - LION OIL COMPANY
Farm - Renner No. 8

SEC. 5 T. 10 R. 20W
SE NW NW

Total Depth. 3846
Comm. 10-21-48 Comp. 11-2-48
Shot or Treated. 3000 acid
Contractor. Glenn Pool Drilling Co., Inc.
Issued. 1-1-49

County. Rooks KANSAS

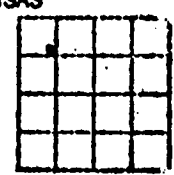

Elevation. _____

Production physpot. 518 BOFD
no wtr

CASING:

8 5/8" 159' com
5 1/2" 3835' com

Figures Indicate Bottom of Formations.

sand	100
shale, shells	1100
shale, sand	1764
anhydrite	1805
shale, shells	2235
lime, shale	2665
shale	2960
shale, shells	3030
shale, lime	3405
lime, shale	3560
lime	3846
Total depth	

Tops:

Arbuckle 3834

RECEIVED
STATE CORPORATION COMMISSION
JUL 16 1969
CONSERVATION DIVISION
Wichita, Kansas