

STATE OF KANSAS
STATE CORPORATION COMMISSION

Form CP-4

WELL PLUGGING RECORD

Give All Information Completely
Make Required Affidavit
Mail or Deliver Report to:
Conservation Division
State Corporation Commission
212 No. Market
Wichita, Kansas

Rooks County, Sec. 5 Twp. 10 Rge. 20 (E) W (W)

Location as "NE/CNW%SW%" or footage from lines C S/2 NWSW

Lease Owner Floyd E. Kelly, L & F Oil Operators

Lease Name W. E. Baldwin Well No. 5

Office Address Box 415, Plainville, Ks. 67663

Character of Well (completed as Oil, Gas or Dry Hole) Oil

Date well completed Unknown 19__

Application for plugging filed Dec. 3, 19 74

Application for plugging approved Dec. 6, 19 74

Plugging commenced Dec. 9, 19 74


Plugging completed Dec. 27, 19 74

Reason for abandonment of well or producing formation Dakota in well at time of purchase of lease.

If a producing well is abandoned, date of last production _____ 19__

Was permission obtained from the Conservation Division or its agents before plugging was commenced? Yes

NORTH

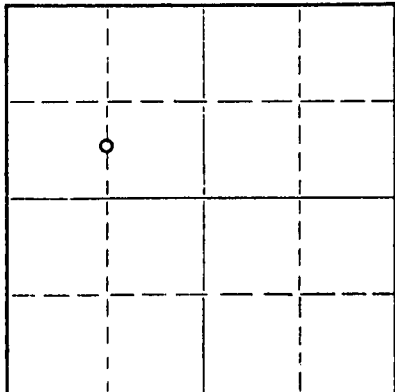

Locate well correctly on above Section Plat

Name of Conservation Agent who supervised plugging of this well Leo F. Massey

Producing formation Arbuckle Depth to top _____ Bottom _____ Total Depth of Well 3,887 Feet

Show depth and thickness of all water, oil and gas formations.

OIL, GAS OR WATER RECORDS

CASING RECORD

FORMATION	CONTENT	FROM	TO	SIZE	PUT IN	PULLED OUT
No information available.						

Describe in detail the manner in which the well was plugged, indicating where the mud fluid was placed and the method or methods used in introducing it into the hole. If cement or other plugs were used, state the character of same and depth placed, from _____ feet to _____ feet for each plug set.

15 gel with 3 hulls	730 - 1600'
50 cem.	580 - 730'
10 gel	180 - 580'
60 cem.	0 - 180'

Plug 2,000' & 4 sx. cem, 2,000 - 1,970

RECEIVED
STATE CORPORATION COMMISSION
2-21-75
FEB 21 1975

CONSERVATION DIVISION
WICHITA, KANSAS

(If additional description is necessary, use BACK of this sheet)
Name of Plugging Contractor Charlie Crow Drilling.
Address Box 706, Hays, Ks. 67601

STATE OF Kansas, COUNTY OF Rooks, ss.
L & F Oil Operator, Floyd E. Kelly (employee of owner) or (owner or operator) of the above-described well, being first duly sworn on oath, says: That I have knowledge of the facts, statements, and matters herein contained and the log of the above-described well as filed and that the same are true and correct. So help me God.

(Signature) Floyd E. Kelly
Plainville Kansas 67663
(Address)

SUBSCRIBED AND SWORN TO before me this 22 day of January, 1975

My commission expires Sept 24 1977
Floyd Wallace
Notary Public.