


Give All Information Completely
Make Required Affidavit
Mail or Deliver Report to:
Conservation Division
State Corporation Commission
212 No. Market
Wichita, Kansas

WELL PLUGGING RECORD

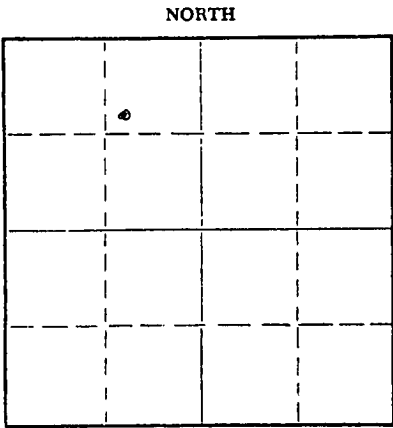

Locate well correctly on above Section Flat

Rooks County, Sec. 5 Twp. 10 Rge. (E) 20 (W)
Location as "NE/CNW/SW" or footage from lines SW NE NW
Lease Owner The Bovaird Supply Company
Lease Name Renner Well No. 8
Office Address P.O. Box 2590, Tulsa, Oklahoma
Character of Well (completed as Oil, Gas or Dry Hole) oil
Date well completed 19
Application for plugging filed July 14 19 69
Application for plugging approved 19
Plugging commenced September 5 19 69
Plugging completed September 6 19 69
Reason for abandonment of well or producing formation depleted

If a producing well is abandoned, date of last production 19
Was permission obtained from the Conservation Division or its agents before plugging was commenced? yes

Name of Conservation Agent who supervised plugging of this well Leo Massey
Producing formation Depth to top Bottom Total Depth of Well 3823 Feet
Show depth and thickness of all water, oil and gas formations.

OIL, GAS OR WATER RECORDS

CASING RECORD

FORMATION	CONTENT	FROM	TO	SIZE	PUT IN	PULLED OUT
		0	194'	8 5/8"	194'	none
		0	3820'	5 1/2"	3820'	271'

Describe in detail the manner in which the well was plugged, indicating where the mud fluid was placed and the method or methods used in introducing it into the hole. If cement or other plugs were used, state the character of same and depth placed, from feet to feet for each plug set.

Sanded back from 3823' to 3800'. Ran 5 sacks of cement from 3800' to 3770'.
Filled hole with mud from 3770' to 700'. Set rock bridge from 700' to 695'. Ran 4 1/2 yards of ready mix cement from 685' to base of cellar.

RECEIVED
STATE CORPORATION COMMISSION
OCT 16 1969
CONSERVATION DIVISION
Wichita, Kansas

Name of Plugging Contractor PIPE PULLERS, INC.
Address Box 486, Ellinwood, Kansas

STATE OF Kansas, COUNTY OF Barton, ss.
Evelyn Roth (employee of owner) or (owner or operator) of the above-described well, being first duly sworn on oath, says: That I have knowledge of the facts, statements, and matters herein contained and the log of the above-described well as filed and that the same are true and correct. So help me God.

(Signature) Evelyn Roth
Ellinwood, Kansas (Address)

SUBSCRIBED AND SWORN TO before me this 25th day of September, 19 69

My commission expires Feb. 10, 1971
George A. Meyer Notary Public.

WELL LOG BUREAU--KANSAS GEOLOGICAL SOCIETY
508 East Murdock, Wichita, Kansas


COPY

Company. LION OIL CO.
Farm. Reener No. 8

SEC. 5 T. 10 R. 20W
SW NE NW

Total Depth. 3823
Comm. 7-20-51 Comp. 7-29-51
Shot or Treated.
Contractor. Glenn W. Peel
Issued. 9-29-51

County Rooks KANSAS

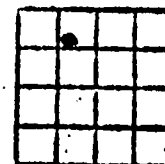

Elevation. 2246

Production. pump 235

Figures Indicate Bottom of Formations.

surface clay	25
sand	80
sand, shale	140
shale, shells	930
sand	1160
shale, shells	1745
anhydrite	1790
shale, shells	2195
lime, shale	2505
broken lime	2625
shale, lime	2715
lime, shale	2825
shale	2960
shale, lime	3185
broken lime	3290
lime, shale	3395
lime	3810
conglomerate	3818
arbuckle	3821
arbuckle	3823
Total depth	

Tops:	
Lansing	3523
Conglomerate	3787
Simpson	3807
Arbuckle	3819