

STATE OF KANSAS
 STATE CORPORATION COMMISSION
 200 Colorado Derby Building
 Wichita, Kansas 67202

WELL PLUGGING RECORD
 K.A.R.-82-3-117

15-163-19432-0000

API NUMBER 09-19-60

LEASE NAME RENNER

WELL NUMBER #9

2310 Ft. from N Section Line

1320 Ft. from W Section Line

SEC. 5 TWP. 10S RGE. 20 (E) or (W)

COUNTY ROOKS

Date Well Completed 09-28-60

Plugging Commenced 04-23-93

Plugging Completed 04-23-93

TYPE OR PRINT
 NOTICE: Fill out completely
 and return to Cons. Div.
 office within 30 days.

LEASE OPERATOR B-J OIL COMPANY

ADDRESS 1503 VINE, SUITE B, HAYS, KS 67601

PHONE# (913) 628-1046 OPERATORS LICENSE NO. 5465

Character of Well D&A

(Oil, Gas, D&A, SWD, Input, Water Supply Well)

The plugging proposal was approved on 04-23-93 (date)

by DENNIS HAMEL (KCC District Agent's Name).

Is ACO-1 filled? N/A If not, is well log attached? N/A

Producing Formation _____ Depth to Top _____ Bottom _____ T.D. 3835'

Show depth and thickness of all water, oil and gas formations.

OIL, GAS OR WATER RECORDS

CASING RECORD

Formation	Content	From	To	Size	Put in	Pulled out
	SURFACE CSG			8 5/8"	232'	NONE
	PROD. CSG			5 1/2"	3833'	NONE

Describe in detail the manner in which the well was plugged, indicating where the mud fluid was placed and the method or methods used in introducing it into the hole. If cement or other plugs were used, state the character of same and depth placed, from _____ feet to _____ feet each set.
 SPOTTED 50 SXS CMT @ 3000'. PULLED TBG & PERFORATED @ 1790', 980' & 230'. RAN TBG BACK TO 2400'.
 SPOTTED 50 SXS WITH 3 HULLS, PULLED TO 1790'. SPOTTED 50 SXS CMT & 1 1/2 HULLS, PULLED TO 980'.
 MIXED 85 SXS & 1/2 HULL, CMT CIRCULATED TO SURFACE. PULLED TBG TIED ON TO S2 MIXED 65 SXS AND TOPPED BACK WITH 10 SXS CMT.

(If additional description is necessary, use BACK of this form.)

Name of Plugging Contractor ALLIED CEMENTING CO., INC. License No. N/A

Address BOX 31, HAYS, KS 67601

NAME OF PARTY RESPONSIBLE FOR PLUGGING FEES: B-J OIL COMPANY


STATE OF KANSAS COUNTY OF ELLIS, ss.

JOHN B. COLLINS (Employee of Operator) of above-described well, being first duly sworn on oath, says: That I have knowledge of the facts, statements, and matters herein contained and the log of the above-described well as filed that the same are true and correct, so help me God.

(Signature) John B. Collins

(Address) 1503 VINE, SUITE B, HAYS, KS 67601

SUBSCRIBED AND SWORN TO before me this 17TH day of JUNE, 19 93

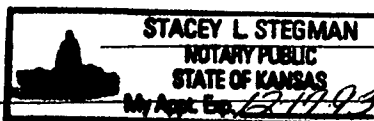

My Commission Expires: _____

Notary Public

RECEIVED
 STATE CORPORATION COMMISSION
 6-21-93
 JUN 21 1993

WELL LOG BUREAU—KANSAS GEOLOGICAL SOCIETY
508 East Murdock, Wichita, Kansas


15-163-19432-0000

Company. LION OIL CO.
Farm. Renner No. 9

SEC. 5 T. 10 R. 20W
C S/2 S/2 NW

Total Depth. 3835'
Comm. 9-19-60 Comp. 9-28-60
Shot or Treated.
Contractor. Garvey Drlg.
Issued. 12-17-60

County Rooks
KANSAS

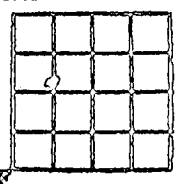

CASING:
8 5/8" 232' cem w/125 sx.
5 1/2" 3833' cem w/650 sx.

Elevation. 2259' DF

Production. 54 BOPD

Figures Indicate Bottom of Formations.

surface sand & clay	50
sandy clay & shale	125
shale	232
shale & shells	910
sand	1015
shale & shells	1090
shells & sand	1675
Anhydrite	1790
shale & lime	2915
lime & shale	3804
lime	3835
Total Depth	
TOPS: SCOUT	
Anhydrite	1675
Heebner	3486
Kansas City	3520
Conglomerate	3792
Arbuckle	3830

RECEIVED
STATE CORPORATION COMMISSION
NOV 19 1969
CONSERVATION DIVISION
Wichita, Kansas