


STATE OF KANSAS
STATE CORPORATION COMMISSION

WELL PLUGGING RECORD

Give All Information Completely
Make Required Affidavit
Mail or Deliver Report to:
Conservation Division
State Corporation Commission
800 Bittling Building
Wichita, Kansas

Rooks County. Sec. 7 Twp. 10 Rge. 20 ~~20X~~ (W)
Location as "NE/CNW $\frac{1}{4}$ SW $\frac{1}{4}$ " or footage from lines NE NE NW
Lease Owner The Derby Oil Company
Lease Name Holmes Well No. 1
Office Address Wichita, Kansas
Character of Well (completed as Oil, Gas or Dry Hole) Dry Hole
Date well completed March 14, 1950
Application for plugging filed March 14, 1950
Application for plugging approved March 14, 1950
Plugging commenced March 14, 1950
Plugging completed March 14, 1950
Reason for abandonment of well or producing formation Dry hole

NORTH

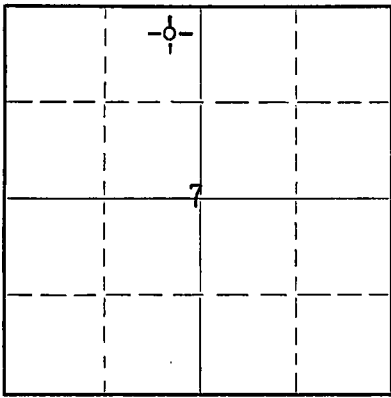

Locate well correctly on above
Section Plat

If a producing well is abandoned, date of last production 19
Was permission obtained from the Conservation Division or its agents before plugging was commenced? Yes

Name of Conservation Agent who supervised plugging of this well E. R. Petty
Producing formation Depth to top Bottom Total Depth of Well 3976 Feet
Show depth and thickness of all water, oil and gas formations.

OIL, GAS OR WATER RECORDS

CASING RECORD

Formation	Content	From	To	Size	Put In	Pulled Out
		0	177'	8 5/8"	177'	None

Describe in detail the manner in which the well was plugged, indicating where the mud fluid was placed and the method or methods used in introducing it into the hole. If cement or other plugs were used, state the character of same and depth placed, from feet to feet for each plug set.

Heavy rotary mud 3976 - 176 $\frac{1}{2}$
 Wooden plug 176 $\frac{1}{2}$ - 175
 Cement 175 - 129
 Heavy rotary mud 129 - 36 $\frac{1}{2}$
 Wooden plug 36 $\frac{1}{2}$ - 35
 Cement 35 - 6
 Cellar 6 - 0

3-23-50

(If additional description is necessary, use BACK of this sheet)

Correspondence regarding this well should be addressed to The Derby Oil Company
Address Box 1030, Wichita, Kansas.

STATE OF Kansas, COUNTY OF Sedgwick, ss.
J. R. Bratcher, (employee of owner) or (owner or operator) of the above-described well,
being first duly sworn on oath, says: That I have knowledge of the facts, statements, and matters herein contained and the log of the above-described well as filed and that the same are true and correct. So help me God.

(Signature) J. R. Bratcher
Derby Oil Company, Wichita, Kansas.
(Address)

SUBSCRIBED AND SWORN TO before me this 21st day of March, 1950

My commission expires August 24, 1953.

H. A. Bilson, Notary Public.

PLUGGING
MARCH 27 1950
WICHITA, KANSAS

15-163-00283-0000
THE DERBY OIL COMPANY

Record of Well No. 1

Holmes

Farm

Location NE NE NW

Sec. 7

Twp. 10S

Rge. 20W

Contractor Glenn Peel Drilling Co., Inc.

County

Rooke

Drilling Commenced March 4, 1950.

State

Kansas

Elevation 2268 Kelly Bushing

Drilling Completed March 14, 1950

CASING RECORD

SIZE	FEET	KIND	WEIGHT	
8 5/8"	177'	New	24#	Cemented with 150 sacks regular Portland cement.

FORMATION	BOTTOM	FORMATION	BOTTOM
Clay	20	<u>GEOLOGICAL TOPS</u>	
Sand	120	Anhydrite	1755
Shale	179	Heebner	3521
Shale & sand	725	Lansing	3558
Sand	825	Conglomerate	3848
Shale & sand	1590	<u>COMPLETION RECORD</u>	
Red bed	1755	Dry and Abandoned.	
Anhydrite	1790		
Shale & shells	2060		
Shale & salt	2150		
Shale	2345		
Lime & shale	2640		
Lime	2750		
Broken lime & shale	2895		
Broken lime	3000		
Lime & shale	3385		
Lime	3870		
Conglomerate	3976		
Rotary total depth	3976		

15-163-00283-0000
 SEC 7 TWP 10S RGE 20W
 143 JUN 11