


STATE OF KANSAS
STATE CORPORATION COMMISSION

Give All Information Completely
Make Required Affidavit
Mail or Deliver Report to:
Conservation Division
State Corporation Commission
800 Bitting Building
Wichita, Kansas

WELL PLUGGING RECORD

NORTH

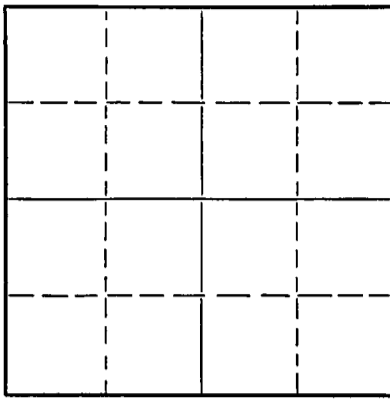

Locate well correctly on above
Section Plat

Rooks County. Sec. 7 Twp. 10 Rge. 20 (E) (W)
Location as "NE/CNW $\frac{1}{4}$ SW $\frac{1}{4}$ " or footage from lines C. SE/4 NE/4 NW/4
Lease Owner Brooks Hall
Lease Name Holmes Well No. 3
Office Address c/o Jones, Shelburne & Farmer, Box 1499, Oklahoma City, Okla.
Character of Well (completed as Oil, Gas or Dry Hole) Dry Hole
Date well completed 2-14 1952
Application for plugging filed Verbal 2-14 1952
Application for plugging approved 2-14 1952
Plugging commenced 2-14 1952
Plugging completed 2-14 1952
Reason for abandonment of well or producing formation Dry Hole

If a producing well is abandoned, date of last production 19
Was permission obtained from the Conservation Division or its agents before plugging was commenced? Yes

Name of Conservation Agent who supervised plugging of this well Eldon E. Petty
Producing formation Depth to top Bottom Total Depth of Well 3890 Feet
Show depth and thickness of all water, oil and gas formations.

OIL, GAS OR WATER RECORDS

CASING RECORD

Formation	Content	From	To	Size	Put In	Pulled Out
				8-5/8"		
				Cemented at 156' w/100 sacks cement and 1 sack C. C.		

Describe in detail the manner in which the well was plugged, indicating where the mud fluid was placed and the method or methods used in introducing it into the hole. If cement or other plugs were used, state the character of same and depth placed, from feet to feet for each plug set.

Filled hole with mud to bottom of surface casing; set bottom plug at 150' with 15 sacks cement and 1/2 sack of hulle; set top at 40' with 10 sacks cement and 1/2 sack hulle.

(If additional description is necessary, use BACK of this sheet)

Name of Plugging Contractor Walters Drilling Co., Inc.
Address 500 Orpheum Building, Wichita, Kansas

STATE OF KANSAS, COUNTY OF SEDGWICK, ss.
Robert F. Walters, Pres., Walters Drilling Co., Inc.

being first duly sworn on oath, says: That I have knowledge of the facts, statements, and matters herein contained and the log of the above-described well as filed and that the same are true and correct. So help me God.

(Signature) Robert F. Walters


500 Orpheum Building, Wichita, Kansas (Address)

SUBSCRIBED AND SWORN to before me this 18th day of February, 1952

F. M. Parker (Signature)

Notary Public.

My commission expires January 11, 1956

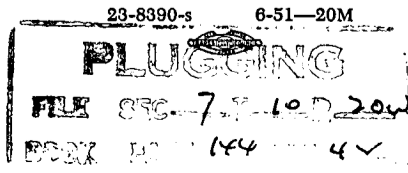

2-27-52

BROOKS HALL HOLMES WELL NO. 3

Location: SE NE NW Section 7-10S-20W Date Spudded: 2-3-52
 Rooks County, Kansas

Operator: Brooks Hall Rotary Completed: 2-14-52

Contractor: Walters Drilling Co., Inc. Elevation: 2264 DF

Surface Casing: 7 Jts., 8-5/8" set @ 156'
 w/100 sacks cement and 1 sack C. C.

Oil String - None D & A Rotary Total Depth: 3890'

LOG

(Figures indicate bottom of formation)

Shale and sand	0 to 155
Shale, shells & sand	641
Shells & shale	1095
Shale & sand	1250
Sand	1480
Shale	1595
Shale & shells	1755
Anhydrite	1789
Shale & shells	2014
Shale	2372
Shale & shells	2492
Shale & lime	2977
Shale	3200
Shale & Lime	3571
Lime	3677
Lime & shale	3758
Lime	3769
Lime & shale	3834
Cherty lime & shale	3889
Lime	3890
Rotary Total Depth	3890

The undersigned, Robert F. Walters, hereby certifies that the above log is a true and correct log of the formations encountered in drilling the above noted well as reflected by the Daily Drilling Reports.

WALTERS DRILLING CO., INC.

By Robert F. Walters
 President

MY COMMISSION EXPIRES JAN. 11, 1956

Subscribed and sworn to
 before me this 18th day of
 February, 1952

J. M. Parker
 Notary Public

