


WELL PLUGGING RECORD

Give All Information Completely
Make Required Affidavit
Mail or Deliver Report to:
Conservation Division
State Corporation Commission
800 Bitting Building
Wichita, Kansas

Rooks County, Sec. 7 Twp. 10S Rge. 20 (E) (W)
C W 1/2 SE 1/4 NW 1/4

Location as "NE/CNW 1/4 SW 1/4" or footage from lines
Lease Owner Brooks Hall
Lease Name Holmes Well No. 2
Office Address Oklahoma City, Oklahoma
Character of Well (completed as Oil, Gas or Dry Hole) Dry
Date well completed February 2, 1952
Application for plugging filed February 2, 1952
Application for plugging approved February 2, 1952
Plugging commenced February 2, 1952
Plugging completed February 2, 1952
Reason for abandonment of well or producing formation Dry

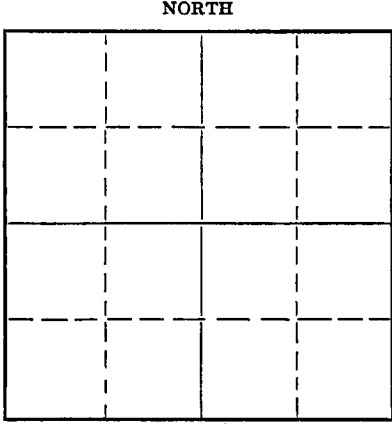

Locate well correctly on above Section Plat

If a producing well is abandoned, date of last production Never produced 19...
Was permission obtained from the Conservation Division or its agents before plugging was commenced? Yes

Name of Conservation Agent who supervised plugging of this well Eldon Petty
Producing formation..... Depth to top..... Bottom..... Total Depth of Well 3899 Feet
Show depth and thickness of all water, oil and gas formations.

OIL, GAS OR WATER RECORDS

CASING RECORD

Formation	Content	From	To	Size	Put In	Pulled Out
				8 5/8"	165'	None

Describe in detail the manner in which the well was plugged, indicating where the mud fluid was placed and the method or methods used in introducing it into the hole. If cement or other plugs were used, state the character of same and depth placed, from.....feet to.....feet for each plug set.

1. Hole was filled with heavy mud.
2. Halliburton plug pushed to 160'.
3. 1/2 sk hulls dumped on top of plug.
4. 15 sks cement mixed and dumped on top of hulls.
5. Halliburton plug pushed to 40'.
6. 1/2 sk hulls dumped on top of plug.
7. 10 sks cement mixed and hole filled to surface with same.

2-6-52

(If additional description is necessary, use BACK of this sheet)

Name of Plugging Contractor JONES, SHELburnE & FARMER, INC.
Address Russell, Kansas

STATE OF KANSAS, COUNTY OF RUSSELL, ss.
JOHN O. FARMER (employee of owner) or (owner or operator) of the above-described well,


being first duly sworn on oath, says: That I have knowledge of the facts, statements, and matters herein contained and the log of the above-described well as filed and that the same are true and correct. So help me God.

(Signature) John O. Farmer
RUSSELL, KANSAS (Address)

SUBSCRIBED AND SWORN to before me this 4th day of February, 19 52.

My commission expires October 24, 1955 George S. Malachuk Notary Public.

7:10 R 20
FOX PAGE 14 X 20

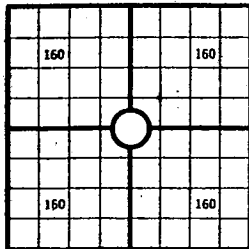OPERATOR Jones, Shelburne & Farmer, Inc.ADDRESS Russell, Kansas640 Acres
N

Locate well correctly.

COUNTY Rooks SEC. 7 TWP. 10S RGE. 20W
 COMPANY OPERATING Jones, Shelburne & Farmer, Inc.
 OFFICE ADDRESS Russell, Kansas
 FARM NAME Holmes WELL NO. 2
 DRILLING STARTED 1-22-52 DRILLING FINISHED 2-2-52
 DATE OF FIRST PRODUCTION Never Produced
 WELL LOCATED W₂ 1/4 SE 1/4 NW 1/4, North of South
 Line and _____ ft. East of West Line of Quarter Section
 Elevation (Relative to sea level) DERRICK FLOOR 2259 GROUND _____
 CHARACTER OF WELL (Oil, gas or dryhole) Dry

OIL OR GAS SANDS OR ZONES

Name	From	To	Name	From	To
1			4		
2			5		
3			6		

Perforating Record If Any

Shot Record

Formation	From	To	No. of Shots	Formation	From	To	Size of Shot

CASING RECORD

Amount Set								Amount Pulled		Packer Record	
Size	Wt.	Thds.	Make	Ft.	In.	Ft.	In.	Size	Length	Depth Set	Make
								3 5/8"	165'		

Liner Record: Amount _____ Kind _____ Top _____ Bottom _____

CEMENTING AND MUDDING

Size	Amount Set		Sacks Cement	Chemical		Method of Cementing	Amount	Mudding Method	Results (See Note)
	Ft.	In.		Gal.	Make				
8 5/8"	165'		100						

Note: What method was used to protect sands if outer strings were pulled? _____

NOTE: Were bottom hole plugs used? _____ If so, state kind, depth set and results obtained _____

TOOLS USED

Rotary Tools were used from _____ feet to _____ feet. Cable tools were used from _____ feet to _____

_____ feet, and from _____ feet to _____ feet, and from _____ feet to _____

Type Rig _____

INITIAL PRODUCTION TEST

Describe initial test: whether by flow through tubing or casing or by pumping _____

Amount of Oil Production _____ bbls. Size of choke, if any _____ Length of test _____ Water

Production _____ bbls. Gravity of oil _____ Type of Pump if pump is used, describe _____

FORMATION RECORD

Give detailed description and thickness of all formations drilled through, contents of sand, whether dry, water, oil or gas.

Formation	Top	Bottom	Formation	Top	Bottom
Shale	0	780			
Sand	780	875			
Shale & Shells	875	1420			
Shale & Shells	1420	1750			
Anhydrite	1750	1940			
Shale & Shells	1940	2340			
Shale & Lime	2340	2450			
Lime & Shale	2450	3015			
Shale & Lime	3015	3115			
Lime & Shale	3115	3565			
Lime	3565	3805			
Lime & Shale	3805	3860			
Chert Lime	3860	3899			
T. D.		3899			

15-163-03392-0000
 COUNTY Rooks
 TWP. 10S
 SEC. 7
 RGE. 20W
 165'

I, the undersigned, being first duly sworn upon oath, state that this well record is true, correct and complete according to the records of this office and to the best of my knowledge and belief.

John W. Farmer
 Vice-President
 Name and title of representative of company

Subscribed and sworn to before me this 5th day of February, 1952
 My Commission expires June 24 1955 *John S. H. Colver*
 Notary Public.

FARM NAME _____ COUNTY _____ TWP. _____ RGE. _____
 WELL NO. _____