

STATE OF KANSAS
STATE CORPORATION COMMISSION


WELL PLUGGING RECORD

Give All Information Completely
Make Required Affidavit
Mail or Deliver Report to:
Conservation Division
State Corporation Commission
211 No. Broadway
Wichita, Kansas

ROOKS County. Sec. 7 Twp. 10S Rge. 20 (E) (W)

Location as "NE/CNW%SW%" or footage from lines SE NW NE
Lease Owner. PETROLEUM, INC.
Lease Name SAUER "B" Well No. 1
Office Address R.R. #2, GREAT BEND, KANSAS
Character of Well (completed as Oil, Gas or Dry Hole) DRY HOLE
Date well completed NOVEMBER 3 1965
Application for plugging filed NOVEMBER 3 1965
Application for plugging approved NOVEMBER 3 1965
Plugging commenced NOVEMBER 3 1965
Plugging completed NOVEMBER 3 1965
Reason for abandonment of well or producing formation NO PRODUCIBLE ZONES

NORTH

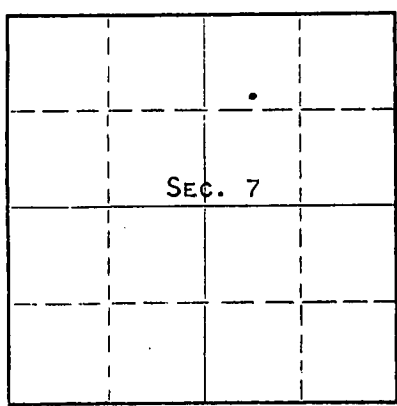

Locate well correctly on above Section Plat

If a producing well is abandoned, date of last production NONE 19
Was permission obtained from the Conservation Division or its agents before plugging was commenced? YES

Name of Conservation Agent who supervised plugging of this well GILBERT LEIKER
Producing formation _____ Depth to top _____ Bottom _____ Total Depth of Well 3510 Feet
Show depth and thickness of all water, oil and gas formations.

OIL, GAS OR WATER RECORDS CASING RECORD

FORMATION	CONTENT	FROM	TO	SIZE	PUT IN	PULLED OUT
				8-5/8"	206	NONE

Describe in detail the manner in which the well was plugged, indicating where the mud fluid was placed and the method or methods used in introducing it into the hole. If cement or other plugs were used, state the character of same and depth placed, from _____ feet to _____ feet for each plug set.

MUDDED UP WITH HEAVY DRILLING MUD TO 540', FOLLOWED BY WOODEN PLUG, PLACED 20 SACKS CEMENT ON TOP OF PLUG. MUDDED UP WITH HEAVY DRILLING MUD TO 200', FOLLOWED BY WOODEN PLUG, PLACED 20 SACKS CEMENT ON TOP OF PLUG. MUDDED UP WITH HEAVY MUD TO 40', FOLLOWED BY WOODEN PLUG, PLACED 1/2 SACK HULLS AND 10 SACKS CEMENT TO BASE OF WELL CELLAR.

RECEIVED
STATE CORPORATION COMMISSION

11-16-65
NOV 16 1965

CONSERVATION DIVISION
WICHITA, KANSAS

(If additional description is necessary, use BACK of this sheet)

Name of Plugging Contractor GARVEY DRILLING CO.
Address R.R. #2, GREAT BEND, KANSAS

STATE OF KANSAS, COUNTY OF BARTON, ss.
MONTE CHADD (employee of owner) or (owner or operator) of the above-described well, being first duly sworn on oath, says: That I have knowledge of the facts, statements, and matters herein contained and the log of the above-described well as filed and that the same are true and correct. So help me God. MONTE CHADD DIST. PROD. SUPT.

(Signature) *Monte Chadd*
ROUTE #2, GREAT BEND, KANSAS
(Address)

SUBSCRIBED AND SWORN TO before me this 15 day of NOVEMBER, 19 65

My commission expires MAY 28, 1969 *Richard A. Dumble* Notary Public.

WELL LOG

15-163-30113-0000

COMPANY Petroleum, Inc.

SEC. 7 T. 10S R. 20W

FARM Sauer

NO. B-1

LOC. SE NW NE


TOTAL DEPTH 3510'

COUNTY Rooks

COMM. 10-29-65

COMP. 11-3-65

CONTRACTOR Garvey Drilling Company

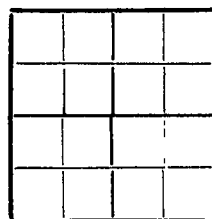

CASING 8 5/8" @ 206' w/175 SX

ELEVATION 2241' KB

PRODUCTION D & A

FIGURES INDICATE BOTTOM OF FORMATIONS

- 90' Sand and Post Rock
- 900' Shale and Shells
- 1060' Sand
- 1235' Sand, Shale, Pyrite
- 1440' Sand
- 1750' Shale and Red Bed
- 1790' Anhydrite
- 2080' Shale and Shells
- 3510' Shale and Lime
- 3510' RTD

RECEIVED
STATE CORPORATION COMMISSION

NOV 16 1965

CONSERVATION DIVISION
Wichita, Kansas

State of Kansas }
 County of Barton } SS

I, Sam N. Stephens of Garvey Drilling Company
 upon oath state the above and foregoing is a true and correct copy of the log of the Sauer B-1 well.

Sam N. Stephens

Subscribed and sworn to before me this 12th day of November 19 65

My Commission Expires: May 28, 1969

Richard N. Dunkel
 NOTARY PUBLIC