


STATE OF KANSAS
STATE CORPORATION COMMISSION

Give All Information Completely
Make Required Affidavit
Mail or Deliver Report to:
Conservation Division
State Corporation Commission
211 No. Broadway
Wichita, Kansas

WELL PLUGGING RECORD

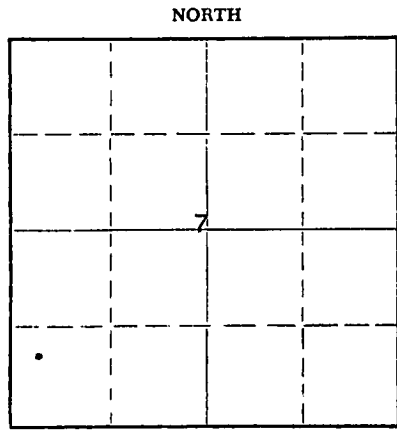

ROOKS County. Sec. 7 Twp. 10S Rge 20 (E) (W)
Location as "NE/CNW/SW" or footage from lines NW SW SW
Lease Owner PETROLEUM, INC.
Lease Name TEMPLE "B" Well No. 3
Office Address R.R. #2, GREAT BEND, KANSAS
Character of Well (completed as Oil, Gas or Dry Hole) DRY HOLE
Date well completed OCT. 5, 19 65
Application for plugging filed OCT. 5, 19 65
Application for plugging approved OCT. 5, 19 65
Plugging commenced OCT. 5, 19 65
Plugging completed OCT. 5, 19 65
Reason for abandonment of well or producing formation NO PRODUCIBLE ZONE

If a producing well is abandoned, date of last production NONE 19
Was permission obtained from the Conservation Division or its agents before plugging was commenced? YES

Name of Conservation Agent who supervised plugging of this well ELDON PETTY
Producing formation _____ Depth to top _____ Bottom 3765' Total Depth of Well _____ Feet
Show depth and thickness of all water, oil and gas formations.

OIL, GAS OR WATER RECORDS				CASING RECORD		
FORMATION	CONTENT	FROM	TO	SIZE	PUT IN	PULLED OUT
				8-5/8"	177'	NONE

Describe in detail the manner in which the well was plugged, indicating where the mud fluid was placed and the method or methods used in introducing it into the hole. If cement or other plugs were used, state the character of same and depth placed, from _____ feet to _____ feet for each plug set.

MUDDERED UP WITH HEAVY MUD TO 540', FOLLOWED BY WOODEN PLUG, PLACED 20 SACKS CEMENT ON TOP OF PLUG, MUDDERED UP WITH HEAVY MUD TO 177', FOLLOWED BY WOODEN PLUG, PLACED 1/4 SACK HULLS AND 20 SACKS CEMENT ON TOP OF PLUG. MUDDERED UP WITH HEAVY MUD TO 25', FOLLOWED BY WOODEN PLUG, 1/4 SACK HULLS AND 10 SACKS CEMENT ON TOP OF PLUG TO BASE OF WELL CELLAR.

10-29-65
OCT 28 1965

(If additional description is necessary, use BACK of this sheet)
Name of Plugging Contractor GARVEY DRILLING CO.
Address R.R. #2, GREAT BEND, KANSAS

STATE OF KANSAS, COUNTY OF BARTON, ss.
MONTE CHADD (employee of owner) or (owner or operator) of the above-described well, being first duly sworn on oath, says: That I have knowledge of the facts, statements, and matters herein contained and the log of the above-described well as filed and that the same are true and correct. So help me God. MONTE CHADD, DIST. PROD. SUPT.

(Signature) *Monte Chadd*
R.R. #2, GREAT BEND, KANSAS
(Address)

SUBSCRIBED AND SWORN TO before me this 27 day of OCTOBER, 19 65

My commission expires MAY 28, 1969
Richard H. Dumble
Notary Public.

WELL LOG

15-163-19433-0001

COMPANY **Petroleum, Inc.**

SEC. 7 T. 10S R. 20W

FARM **Temple**

NO. **B-3 Wash Down**

LOC. **NW SW SW**


TOTAL DEPTH **3765'**

COUNTY **Rooks**

COMM. **9-27-65**

COMP. **10-5-65**

CONTRACTOR **Garvey Drilling Company**

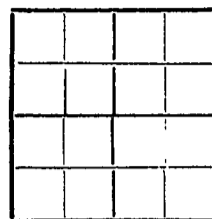

CASING

ELEVATION **2176' KB**

PRODUCTION **D & A**

FIGURES INDICATE BOTTOM OF FORMATIONS

- 1665' Shale
- 1708' Anhydrite
- 2280' Shale and Shells
- 2700' Lime and Shale
- 2845' Shale and Lime
- 3310' Lime and Shale
- 3535' Lime
- 3672' Lime and Shale
- 3765' Lime
- 3765' RTD

RECORDED
 OCT 29 1965
 NOTARY PUBLIC

State of Kansas }
 County of Barton } SS

I, Sam N. Stephens of Garvey Drilling Company

upon oath state the above and foregoing is a true and correct copy of the log of the Temple B-3 Wash Down well.

Sam N. Stephens

Subscribed and sworn to before me this 25th day of October 19 65

My Commission Expires: May 28, 1969

Richard W. Dumas
 NOTARY PUBLIC