


WELL PLUGGING RECORD

Give All-Information Completely
Make Required Affidavit
Mail or Deliver Report to:
Conservation Division
State Corporation Commission
800 Bitting Building
Wichita, Kansas

NORTH

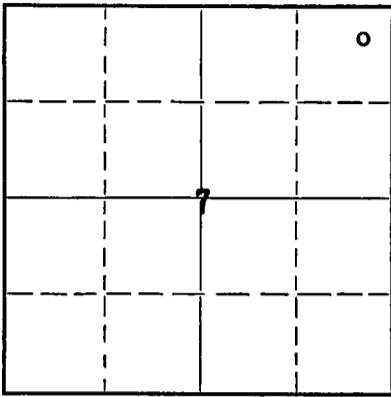

Locate well correctly on above
Section Plat

Rooks County. Sec. 7 Twp. 10S Rge. (E) 20 (W)
Location as "NE/CNW $\frac{1}{4}$ SW $\frac{1}{4}$ " or footage from lines NE/4 NE/4 NE/4
Lease Owner Brooks Hall
Lease Name SAUER Well No. 1
Office Address 2818 First Natl. Bldg., Okla. City, Okla.
Character of Well (completed as Oil, Gas or Dry Hole) dry hole
Date well completed 8-17- 1951
Application for plugging filed 8-17- 1951
Application for plugging approved 8-17- 1951
Plugging commenced 8-17- 1951
Plugging completed 8-17- 1951
Reason for abandonment of well or producing formation ---
If a producing well is abandoned, date of last production --- 19
Was permission obtained from the Conservation Division or its agents before plugging was commenced? yes

Name of Conservation Agent who supervised plugging of this well Eldon Petty, Box 326, Hays, Kansas
Producing formation --- Depth to top --- Bottom --- Total Depth of Well 3879 Feet
Show depth and thickness of all water, oil and gas formations.

OIL, GAS OR WATER RECORDS

CASING RECORD

Formation	Content	From	To	Size	Put In	Pulled Out
none	---	---	---	8-5/8"	7 jts.	none pulled
				cement @ 152' w/120		
				sacks Victor cement		
				and 1 sack Cal. Chlor.		

Describe in detail the manner in which the well was plugged, indicating where the mud fluid was placed and the method or methods used in introducing it into the hole. If cement or other plugs were used, state the character of same and depth placed, from --- feet to --- feet for each plug set.

Filled hole with heavy mud; put bottom hole plug @ 150' w/15 sacks;
top hole plug 55' w/10 sacks. Cut pipe off 3' below level of ground.

9-4-51
SEP 4 X 1951
CONSERVATION DIVISION
Wichita, Kansas

(If additional description is necessary, use BACK of this sheet)

Correspondence regarding this well should be addressed to Brooks Hall
Address 2818 First National Building, Oklahoma City, Okla.

STATE OF Kansas, COUNTY OF Sedgwick, ss.
H. D. Shreve (employee of contractor) of the above-described well,
being first duly sworn on oath, says: That I have knowledge of the facts, statements, and matters herein contained and the log of the above-described well as filed and that the same are true and correct. So help me God. FRED DRILLING CO.

(Signature) by: [Signature]
509 Orpheum Bldg., Wichita 2, Kansas
(Address)

SUBSCRIBED AND SWORN to before me this 20th day of August, 1951

My commission expires June 28, 1952 [Signature] Notary Public.

PLUGGING
FILE SEC 7T/DRY(2)
BOOK PAGE 104 LINE 34

SAUER NO. 1 WELL

Location: NE/4 NE/4 NE/4 Sec.7-10S-20W Date Spudded: 8-6-51
Rooks County, Kansas

Operator: Brooks Hall Rotary Completion: 8-17-51
Oklahoma City, Okla. Elevation: 2271 DF
2273 KB

Contractor: Fred Drilling Co. Rotary T.D.: 3879'

Surface Casing: 7 jts. 8-5/8" cemented @ 152&
w/120 sacks Victor cement and
1 sack Calcium Chloride.

Oil String: None run - D&A 8-17-51

T O P S KB

Anhydrite	1799 (+ 474)
Topeka lime	3314 (-1041)
Heebner shale	3517 (-1244)
Lansing-Kansas City lime	3555 (-1282)
Base of Kansas City "	3772 (-1499)
Simpson shale	3793 (-1520)
Arbuckle dolomite	3876 (-1603)
Rotary Total Depth	3879 (-1606)

L O G

(Figures indicate bottom of formation)


Sand and shale	0 to 154
Cement	157
Sand - shale	369
Sand and shale	1060
Shale and sand	1290
Sand	1525
Shale and lime shells	1600
Shale	1799
Anhydrite	1834
Shale	1840
Shale and shells	2368
Shale and lime	2950
Shale	3310
Lime and shale	3597
Lime	3651
Lime	3724
Lime and shale	3879
Total Depth	3879'

The undersigned H. D. Shreve of the Fred Drilling Co. hereby certifies that the above is a true and correct log of the formations encountered in drilling the SAUER #1 well as shown on the daily drilling reports.

FRED DRILLING CO.

BY 

Subscribed and sworn to before
me this 20th day of August 1951.

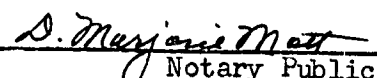
Notary Public

My commission expires: June 28, 1952

PLUGGING
FILE SEC-7-T-10R-20W
BOOK PAGE-104-LINE 34