


15-163-19433-0000

WELL PLUGGING RECORD

NORTH

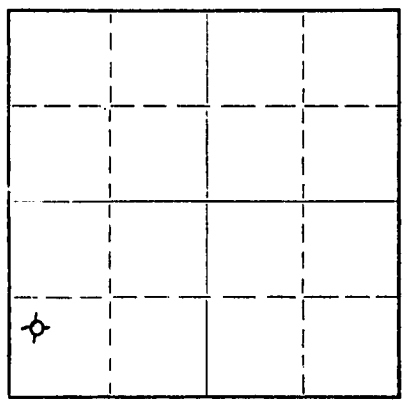

Locate well correctly on above
Section Plat

ROOKS County. Sec. 7 Twp. 10 Rge. 20 (E) W (W)
Location as "NE/CNW/SW" or footage from lines NW SW SW
Lease Owner C-G DRILLING CO. & D. G. HANSEN
Lease Name TEMPLE Well No. 1
Office Address 107 RULE BLDG., WICHITA, KANSAS
Character of Well (completed as Oil, Gas or Dry Hole) dry Hole
Date well completed February 17 19 56
Application for plugging filed February 17 19 56
Application for plugging approved February 17 19 56
Plugging commenced February 18 19 56
Plugging completed February 18 19 56
Reason for abandonment of well or producing formation Too low structurally

If a producing well is abandoned, date of last production 19
Was permission obtained from the Conservation Division or its agents before plugging was commenced? Yes

Name of Conservation Agent who supervised plugging of this well Eldon Petty, Hays, Kansas
Producing formation Depth to top Bottom Total Depth of Well 3864 Feet
Show depth and thickness of all water, oil and gas formations.

OIL, GAS OR WATER RECORDS

CASING RECORD

FORMATION	CONTENT	FROM	TO	SIZE	PUT IN	PULLED OUT
				8-5/8"	177'	none

Describe in detail the manner in which the well was plugged, indicating where the mud fluid was placed and the method or methods used in introducing it into the hole. If cement or other plugs were used, state the character of same and depth placed, from feet to feet for each plug set.

Filled hole with heavy mud to 170'. Set plug. Put in 1/2 sack Hulls and 15 sacks of cement. Filled with heavy mud up to 40'. Set Plug. Filled to top with 1/2 sack Hulls and 10 sacks cement.

(If additional description is necessary, use BACK of this sheet)

Name of Plugging Contractor C-G DRILLING CO.
Address 107 RULE BLDG., WICHITA, KANSAS

STATE OF KANSAS, COUNTY OF SEDGWICK, ss.
G. F. Galloway (employee of owner) or (owner or operator) of the above-described well, being first duly sworn on oath, says: That I have knowledge of the facts, statements, and matters herein contained and the log of the above-described well as filed and that the same are true and correct. So help me God.

(Signature) G. F. Galloway 107 Rule Bldg.
(Address)

SUBSCRIBED AND SWORN TO before me this 20th day of February, 1956

My commission expires May 20, 1959 Vicky Jacobs Notary Public.
STATE CORPORATION COMMISSION
2-23-56
FEB 23 1956

PLUGGING
FILE SEC 7 T 10 R 30
BOOK PAGE 40 LINE 1

15-163-19433-0000

CONTRACTOR'S WELL LOG

OPERATOR C-G DRILLING CO. & D. G. HANSEN WELL NAME TEMPLE #1

LOCATION NW SW SW SEC. 7-10S-20W RIG NO. 1

COUNTY ROOKS STATE KANSAS

COMMENCEMENT DATE FEBRUARY 8, 1956 COMPLETION DATE FEBRUARY 18, 1956

LOG OF WELL

Elevation 2176' rotary bushing.
All measurements taken from top of rotary bushing.

FROM	TO	FORMATION	DEVIATION	remarks
			FROM VERTICAL	
0	177	Surface Soil		
177	520	Shale		
520	1170	Shale-Sand		
1170	1410	Sand		
1410	1510	Red Bed		
1510	1678	Red Bed		
1678	1717	Anhydrite		
1717	1960	Shale-Shells		
1960	2210	Shale		
2210	2400	Lime-Shale		
2400	2525	Lime-Shale	0° - 2500	
2525-	2640	Lime-Shale		
2640	2750	Lime-Shale	0° - 2750	
2750	2860	Lime-Shale		
2860	2975	Lime-Shale		
2975	3100	Lime-Shale	0° - 3000	
3100	3180	Lime-Shale		
3180	3290	Lime-Shale	0° - 3250	
3290	3370	Lime-Shale		
3370	3420	Lime-Shale		
3420	3480	Lime-Shale		
3480	3525	Lime-Shale	0° - 3500	
3525	3539	Lime-Shale		DST 3529-39'
3539	3615	Lime-Shale		
3615	3720	Lime-Shale		
3720	3754	Lime-Shale	0° 3750	
3754	3790	Conglomerate		
3790	3845	Lime-Shale	0° - 3800	
3845	3864	Lime-Shale		

CASING LEFT IN HOLE AFTER COMPLETION

177' 8-5/8" OD Surface Casing.

STATE OF KANSAS, COUNTY OF SEDGWICK) ss.

The undersigned hereby certifies that to the best of his knowledge and belief, the above facts are true and correct.

C-G DRILLING CO.

By G. F. Galloway
G. F. Galloway

Subscribed and sworn to before me on this 20th day of February, 1956.

My commission expires;
May 20, 1959

Vicky Jacobs
Vicky Jacobs, Notary Public

