


STATE OF KANSAS
 STATE CORPORATION COMMISSION
 Give All Information Completely
 Make Required Affidavit
 Mail or Deliver Report to:
 Conservation Division
 State Corporation Commission
 800 Bitting Building
 Wichita, Kansas

15-051-00053-00-00
WELL PLUGGING RECORD

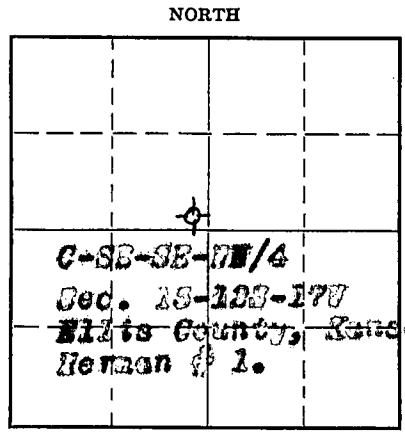

Blits County. Sec. **15** Twp. **123** Rge. **17** (E) (W)
 Location as "NE/CNW/SW" or footage from lines **C-SE-SE-N7/4**
 Lease Owner **Lee Phillips Oil Company**
 Lease Name **Herman #1**
 Office Address **Union National Bank Bldg. Wichita, Kansas.**
 Character of Well (completed as Oil, Gas or Dry Hole) **Dry Hole**
 Date well completed **7-29** 19 **51**
 Application for plugging filed **7-29** 19 **51**
 Application for plugging approved **7-29** 19 **51**
 Plugging commenced **7-29** **0:00 AM.** 19 **51**
 Plugging completed **7-29** **1:00 AM** 19 **51**
 Reason for abandonment of well or producing formation **Dry Hole**

If a producing well is abandoned, date of last production _____ 19____
 Was permission obtained from the Conservation Division or its agents before plugging was commenced? **Yes Verbal**

Name of Conservation Agent who supervised plugging of this well **Eldon Petty**
 Producing formation _____ Depth to top _____ Bottom _____ Total Depth of Well **3712** Feet
 Show depth and thickness of all water, oil and gas formations.

OIL, GAS OR WATER RECORDS

CASING RECORD

Formation	Content	From	To	Size	Put In	Pulled Out
Roadrock		0	210'	8 5/8"	210'	none
Kansas City		3391	3625		none	none
Arbuckle		3674	3712		none	none

Describe in detail the manner in which the well was plugged, indicating where the mud fluid was placed and the method or methods used in introducing it into the hole. If cement or other plugs were used, state the character of same and depth placed, from _____ feet to _____ feet for each plug set.

Stirred bits & filled hole with heavy mud, broke down drill pipe, set bottom Wood Plug at 210'. Mixed & ran through drill pipe 10 sacks of cement on bottom Plug. Filled hole with heavy mud to 40' set Wood plug at 40 feet. Put 1/2 sack balls and 10 sacks of cement on bottom Plug to fill to bottom of cellar.

8-3-1951

(If additional description is necessary, use BACK of this sheet)
 Correspondence regarding this well should be addressed to **Lee Phillips Oil Company**
 Address **Union National Bank Bldg. Wichita, Kansas.**

STATE OF **Kansas**, COUNTY OF **Blits**, ss.
F.C. Strain (employee of owner) or (owner or operator) of the above-described well, being first duly sworn on oath, says: That I have knowledge of the facts, statements, and matters herein contained and the log of the above-described well as filed and that the same are true and correct. So help me God.
 (Signature) **F.C. Strain**
Box 100 Hays, Kansas.
 (Address)

SUBSCRIBED AND SWORN to before me this **30** day of **July**, 19 **51**
Dolores Ann Fair
 Notary Public.

My commission expires **July 18, 1955**

PLUGGING
FILE SEC 15 T 17 R 70
BOOK PAGE 99 LINE 22

WELL LOG

COMPANY: Lee Phillips Oil Company

C-SE-SE-NW Sec. 15,
Twp. 12S, Rge. 17W,
Ellis County, Kansas.

LEASE: Herman #1

ELEVATION: 2144 Derrick Floor.

NOTE: All meas. rotary bushing.

0	60 Postrock & shale
60	90 Sand
90	120 Shale & shells
120	214 Blue shale & shells
214	432 Shale
432	440 Shale
440	792 Sand
792	812 Loose shale
812	1020 Sand
1020	1120 Shale
1120	1320 Shale & lime
1320	1346 Shale
1346	1390 Anhydrite
1390	1425 Shale & lime
1425	1740 Shale & shells
1740	1845 Salt
1845	2090 Shale & Lime
2090	2245 Lime & shale
2245	2400 Lime & shale
2400	2485 Lime & shale
2485	2675 Lime & shale
2675	2800 Lime & shale
2800	2955 Shale & lime
2955	3030 Lime & shale
3030	3153 Lime & shale
3153	3245 Lime & shale
3245	3280 Lime & shale
3280	3345 Lime & shale
3345	3415 Shale & Lime
3415	3465 Shale & lime
3465	3495 Lime
3495	3560 Lime
3560	3610 Lime
3610	3669 Lime
3669	3682 Lime
3682	3686 Arb. Lime
3686	3688 Lime
3688	3697 Lime
3697	3707 Lime
3707	3712 Lime
3712	T.D. (Rotary bushing meas.)

Commenced: 7-18-51
Completed: 7-29-51

CASING RECORD:

8 5/8" surface casing set at
214' w/150 sacks cement.
Cemented By Globe Cementing Co.

D.S.T by Johnston Testing Co.

3675'-3682' Tool open 40 min.
Recovered 10 foot Rotary mud.
B.H.P. 10 min. 620# Press.

3680'-3688' Tool open 1 Hour.
Recovered 60' Watery Rotary mud.
B.H.P. 10 min. 870# press.

Ran Schlumberger Log to T.D.

TOPS:

Anhydrite	1346
Topeka	3107
Heebner	3345
Toronto	3367

Kansas City	3391
Base K.C.	3625
Simpson	3661
Arbuckle	3674
T.D.	3712

STATE OF KANSAS) SS
COUNTY OF ELLIS)

I hereby affirm that the above and foregoing is a true and correct copy of the log of the Herman #1, Located C-SE-SE-NW, Sec. 15, Twp. 12S, Rge. 17W, Ellis County, Kansas.

PLUGGING CONTRACTOR: Strain Drilling Company

FILE SEC 15 T 17 R 12
BOOK PAGE 99 LINE 3

By: *J.P. Strain*

Subscribed and sworn to before me this 30 day of July, 1951

My Commission expires July 18, 1955.

Delores Ann Fair
NOTARY PUBLIC