


Give All Information Completely
Make Required Affidavit
Mail or Deliver Report to:
Conservation Division
State Corporation Commission
212 North Market, Insurance Bldg.
Wichita, Kansas

Ellis County, Sec. 16 Twp. 12 Rge. 17 (E) W (W)
Location as "NE/CNW/SW" or footage from lines S/W - N/E - N/W

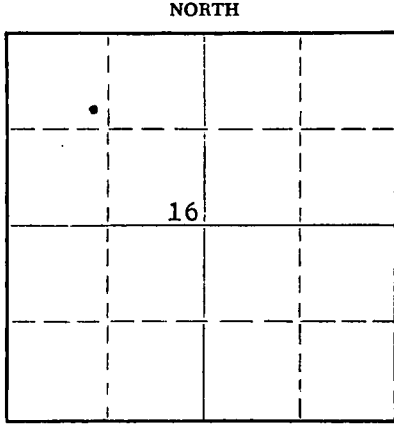

Locate well correctly on above Section Plat

Lease Owner Nadel and Gusman Oil Producers
Lease Name Maye Bemis Well No. 1
Office Address _____
Character of Well (completed as Oil, Gas or Dry Hole) Dry Hole
Date well completed May 29 19 60
Application for plugging filed May 29 19 60
Application for plugging approved May 29 19 60
Plugging commenced May 29 19 60
Plugging completed May 29 19 60
Reason for abandonment of well or producing formation _____

If a producing well is abandoned, date of last production _____ 19 _____
Was permission obtained from the Conservation Division or its agents before plugging was commenced? Yes

Name of Conservation Agent who supervised plugging of this well Lawrence Petty
Producing formation _____ Depth to top _____ Bottom _____ Total Depth of Well 3740 Feet
Show depth and thickness of all water, oil and gas formations.

| OIL, GAS OR WATER RECORDS | | | | CASING RECORD | | |
|---------------------------|---------|------|----|---------------|--------|------------|
| FORMATION | CONTENT | FROM | TO | SIZE | PUT IN | PULLED OUT |
| | | | | | | |
| | | | | | | |
Describe in detail the manner in which the well was plugged, indicating where the mud fluid was placed and the method or methods used in introducing it into the hole. If cement or other plugs were used, state the character of same and depth placed, from _____ feet to _____ feet for each plug set.

Filled hole with heavy mud to 550' and cemented with 20 sacks of cement filled hole heavy mud to 180' and cemented with 20 sacks of cement, filled hole with heavy mud to 40' and cemented with 10 sacks of cement to top.

RECEIVED
STATE CORPORATION COMMISSION
6-20-1960
JUN 20 1960
CONSERVATION DIVISION
Wichita, Kansas

(If additional description is necessary, use BACK of this sheet)
Name of Plugging Contractor Jones Drilling Company
Address Great Bend, Kansas

STATE OF Kansas, COUNTY OF Barton, ss.
A. M. Jones (employee of owner) or (owner or operator) of the above-described well, being first duly sworn on oath, says: That I have knowledge of the facts, statements, and matters herein contained and the log of the above-described well as filed and that the same are true and correct. So help me God.

(Signature) [Signature]
P. O. Box 126, Great Bend, Kansas
(Address)

SUBSCRIBED AND SWORN TO before me this 14th day of June, 19 60

My commission expires April 11, 1963 John W. Poos Notary Public.



WELL LOG

Date started 5-20-60
Date completed 5-29-60

Maye Bemis #1
N.W.C.
Sec. 16-12S-17W
Ellis County, Kansas

Elevation 2159' KB
Anhydrite 1383' (-776)
Heebner 3379' (-1220')
Toronto 3402' (-1243')
Lansing 3424' (-1265')
Conglomerate 3671' (-1512')
T.D. 3740' (-1581')

8 5/8" set at 204.27'

0' - 205' Shale
205' - 687' Shale and clay
687' - 780' Sand
780' - 995' Sand and shale
995' - 1383' Shale
1383' - 1425' Anhydrite
1425' - 1865' Shale and shell
1865' - 2590' Lime and shale
2590' - 2810' Shale
2810' - 3367' Lime and shale
3367' - 3675' Lime
3675' - 3690' Lime and shale
3690' - 3725' Chesty conglomerate
3725' - 3740' Conglomerate

RECEIVED
STATE COMMISSIONER
6-20-1960
JUN 23 1960

AFFIDAVIT

State of Kansas County of Barton

I, A. M. Jones, certify that the above is a true and correct log as reflected by the Daily Drilling Reports of the Jones Drilling Company.

By: *A. M. Jones*
A. M. Jones Owner

Subscribed and sworn before me this 14th day of June, 1960.

John W. Poos
Notary Public - John W. Poos

My commission expires April 11, 1963