


STATE OF KANSAS  
STATE CORPORATION COMMISSION

Form CP-4

Give All Information Completely  
Make Required Affidavit  
Mail or Deliver Report to:  
Conservation Division  
State Corporation Commission  
211 No. Broadway  
Wichita, Kansas

15-051-30054-00-00  
WELL PLUGGING RECORD

NORTH

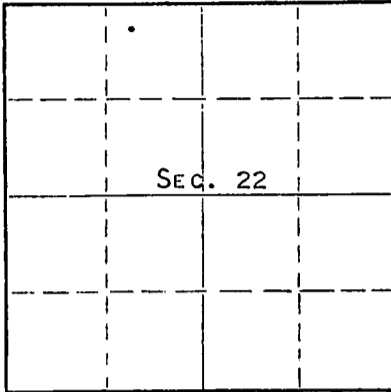

Locate well correctly on above  
Section Plat

ELLIS County. Sec. 22 Twp. 12s Rge. X (X) 17(W)  
Location as "NE/CNW/SW" or footage from lines NW NE NW  
Lease Owner PETROLEUM, INC.,  
Lease Name DINKEL "F" Well No. 1  
Office Address ROUTE #2, GREAT BEND, KANSAS  
Character of Well (completed as Oil, Gas or Dry Hole) DRY HOLE  
Date well completed MARCH 26 19 65  
Application for plugging filed MARCH 26 19 65  
Application for plugging approved MARCH 26 19 65  
Plugging commenced MARCH 26 19 65  
Plugging completed MARCH 26 19 65  
Reason for abandonment of well or producing formation NO PRODUCIBLE ZONES

If a producing well is abandoned, date of last production -- 19  
Was permission obtained from the Conservation Division or its agents before plugging was commenced? YES

Name of Conservation Agent who supervised plugging of this well ELDON PETTY, Box 326, HAYS, KANSAS  
Producing formation \_\_\_\_\_ Depth to top \_\_\_\_\_ Bottom \_\_\_\_\_ Total Depth of Well 3350 Feet  
Show depth and thickness of all water, oil and gas formations.

OIL, GAS OR WATER RECORDS

CASING RECORD

FORMATION	CONTENT	FROM	TO	SIZE	PUT IN	PULLED OUT
				8-5/8	210'	NONE

Describe in detail the manner in which the well was plugged, indicating where the mud fluid was placed and the method or methods used in introducing it into the hole. If cement or other plugs were used, state the character of same and depth placed, from \_\_\_\_\_ feet to \_\_\_\_\_ feet for each plug set.

MUDDERED UP WITH HEAVY MUD THROUGH DRILL PIPE TO 540', FOLLOWED BY A WOODEN PLUG AND 20 SACKS CEMENT. MUDDERED UP WITH HEAVY MUD TO 210', FOLLOWED BY A WOODEN PLUG, 1/4 SACK HULLS AND 20 SACKS CEMENT. MUDDERED UP WITH HEAVY MUD TO 35', FOLLOWED BY A WOODEN PLUG, 1/2 SACK HULLS AND 10 SACKS CEMENT TO BASE OF WELL CELLAR.

RECEIVED  
STATE CORPORATION COMMISSION  
4-13-1965  
APR 13 1965

CONSERVATION DIVISION  
Wichita, Kansas

(If additional description is necessary, use BACK of this sheet)  
Name of Plugging Contractor GARVEY DRILLING CO.  
Address ROUTE #2, GREAT BEND, KANSAS

STATE OF KANSAS, COUNTY OF BARTON, ss.  
MONTE CHADD (employee of owner) or (owner or operator) of the above-described well, being first duly sworn on oath, says: That I have knowledge of the facts, statements, and matters herein contained and the log of the above-described well as filed and that the same are true and correct. So help me God. MONTE CHADD, DIST. PROD. SUPT.

(Signature) *Monte Chadd*  
ROUTE #2, GREAT BEND, KANSAS  
(Address)

SUBSCRIBED AND SWORN TO before me this 12 day of APRIL, 19 65

My commission expires OCTOBER 19, 1968

*Rouie D. Stearns*  
Notary Public.

15-051-30054-00-00  
WELL LOG

COMPANY Petroleum, Inc.

SEC. 22 T. 12S R. 17W

FARM Dinkel

NO. F-1

LOC. App SW NE


TOTAL DEPTH 3350'

COUNTY Ellis

COMM. 3-21-65

COMP. 3-26-65

CONTRACTOR Garvey Drilling Company

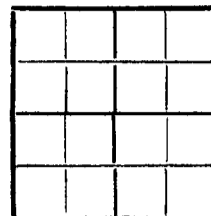

CASING 8 5/8" @ 210' w/225 sx

ELEVATION 2121' DF

PRODUCTION D & A

FIGURES INDICATE BOTTOM OF FORMATIONS

- 10' Clay
- 40' Post Rock
- 310' Shale and Shells
- 655' Shale and Sand Streaks
- 704' Sand
- 729' Pyrite and Sand
- 965' Shale and Sand
- 1320' Shale
- 1359' Anhydrite
- 1920' Shale
- 2140' Shells and Shale
- 2260' Shale
- 2490' Lime and Shale
- 2720' Shale and Lime
- 3040' Lime and Shale
- 3172' Shale and Lime
- 3260' Lime and Shale
- 3330' Lime
- 3350' Lime and Shale
- 3350' RTD

RECEIVED  
STATE CORPORATION COMMISSION  
4-13-1965  
APR 13 1965

CONSERVATION DIVISION  
Wichita, Kansas

State of Kansas }  
County of Barton } BS

I, Sam N. Stephens of Garvey Drilling Company

upon oath state the above and foregoing is a true and correct copy of the log of the Dinkel F-1 well.

Subscribed and sworn to before me this 1st day of April 19 65

My Commission Expires: October 19th, 1968

NOTARY PUBLIC