


STATE OF KANSAS
STATE CORPORATION COMMISSION

15-051-01263-00-00
WELL PLUGGING RECORD

Give All Information Completely
Make Required Affidavit
Mail or Deliver Report to:
Conservation Division
State Corporation Commission
211 No. Broadway
Wichita, Kansas

NORTH

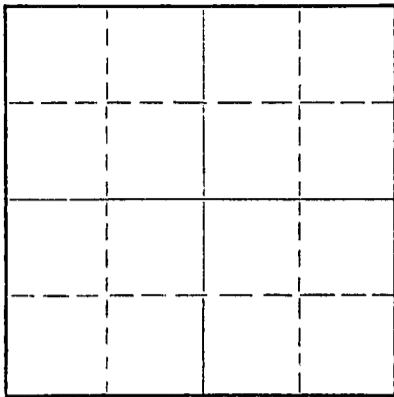

Locate well correctly on above
Section Plat

ELLIS County. Sec. 30 Twp. 12S Rge. 17W (E) (W)
Location as "NE/CNW&SW&" or footage from lines NW SE SE
Lease Owner K & E DRILLING, INC., OIL TRADING, AND NATE APPELMAN
Lease Name KARLIN 'D' Well No. 1
Office Address 719 Union Center Building, Wichita 2, Kansas
Character of Well (completed as Oil, Gas or Dry Hole) Dry Hole
Date well completed 3-4-57 19__
Application for plugging filed 3-4-57 19__
Application for plugging approved 3-4-57 19__
Plugging commenced 3-4-57 19__
Plugging completed 3-4-57 19__
Reason for abandonment of well or producing formation _____

If a producing well is abandoned, date of last production _____ 19__
Was permission obtained from the Conservation Division or its agents before plugging was commenced? yes

Name of Conservation Agent who supervised plugging of this well Eldon Petty
Producing formation _____ Depth to top _____ Bottom _____ Total Depth of Well 3675 Feet
Show depth and thickness of all water, oil and gas formations.

OIL, GAS OR WATER RECORDS

CASING RECORD

FORMATION	CONTENT	FROM	TO	SIZE	PUT IN	PULLED OUT
				<u>8-5/8</u>	<u>167</u>	

Describe in detail the manner in which the well was plugged, indicating where the mud fluid was placed and the method or methods used in introducing it into the hole. If cement or other plugs were used, state the character of same and depth placed, from _____ feet to _____ feet for each plug set.

Filled with heavy mud to 400' set solid bridge with 20 sx cement thru pipe. Filled with heavy mud to 40' set solid plug with 10 sx cement. Plugging complete.

3-12-1957

(If additional description is necessary, use BACK of this sheet)
Name of Plugging Contractor K & E DRILLING, INC.
Address 719 Union Center Building, Wichita 2, Kansas

STATE OF KANSAS, COUNTY OF SEDGWICK, ss.
Dale Silcott (employee of owner) or (owner or operator) of the above-described well, being first duly sworn on oath, says: That I have knowledge of the facts, statements, and matters herein contained and the log of the above-described well as filed and that the same are true and correct. So help me God.

(Signature) Dale Silcott
Dale Silcott, Asst Secy of K & E DRILLING, INC.
719 Union Center Building, Wichita 2, Kansas
(Address)

SUBSCRIBED AND SWORN TO before me this 8th day of March, 19 57

My commission expires 11 August 1958
Patricia M. Edwards Notary Public.

PLUGGING
FILE SEC 30 T. 12 R. 17w
BOOK PAGE 147 LINE 8

15-051-01263-00-00

W E L L L O G

OPERATOR:	K & E, OIL TRADING & APPLEMAN 719 Union Center Building Wichita 2, Kansas	FARM NAME:	#1 KARLIN 'D'
CONTRACTOR:	K & E DRILLING, INC. 719 Union Center Wichita 2, Kansas	LOCATION:	NW SE SE Sec. 30-12S-17W Ellis County Kansas
CASING RECORD:	8-5/8" @ 167' (135 sx)	COMMENCED:	2-25-57
R.T.D.	3675'	COMPLETED:	3-4-57
PRODUCTION:	D & A	ELEVATION:	2086' KB 2083' DF

FORMATION RECORD

Depths shown indicate bottom of formations

Shale	725
Sand & Shale	990
Shale	1308
Anhydrite	1352
Shale	1410
Shale & Shells	2200
Shale & Lime	2370
Lime & Shale	2855
Shale & Lime	3175
Lime	3323
Shale	3326
Lime	3595
Lime & Shale	3650
Lime	3675
R.T.D.	3675

CERTIFICATION

STATE OF KANSAS)
) SS;
COUNTY OF SEDGWICK)

I, Dale Silcott, of the K & E DRILLING, INC., upon oath state that the above and foregoing is a true and correct copy of the log of the #1 KARLIN 'D' well.

Dale Silcott

Dale Silcott

Subscribed and sworn to before me this 11th day of March, 1957.

Patricia M. Edwards

Patricia M. Edwards, Notary Public

My commission expires: 11 August 1958.

3-12-1957

PLUGGING
FILE SEC 30 T 12 R 17W
BOOK PAGE 147 LINE 8