


STATE OF KANSAS  
STATE CORPORATION COMMISSION

15-051-21595-00-00  
WELL PLUGGING RECORD

Give All Information Completely  
Make Required Affidavit  
Mail or Deliver Report to  
Conservation Division  
State Corporation Comm.  
245 North Water  
Wichita, KS 67202

Ellis County, Sec. 30 Twp. 12S Rge. 17W E/W  
Location as "NE/CNW $\frac{1}{4}$ SW $\frac{1}{4}$ " or footage from lines  
C NE NE

Lease Owner Brooks Hall Oil Corporation  
Lease Name Schmeidler Well No. 1  
Office Address 101 Park Ave, Suite 600, Okla City Okla 73102  
Character of Well (Completed as Oil, Gas or Dry Hole)  
Dryhole

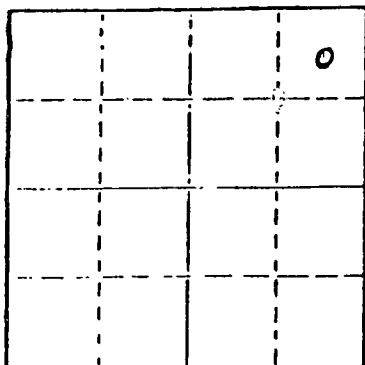

Locate well correctly on above  
Section Plat

Date Well completed 12-16 1978  
Application for plugging filed 12-16 (Verbal) 1978  
Application for plugging approved 12-16 1978  
Plugging commenced 12-16 1978  
Plugging completed 12-16 1978  
Reason for abandonment of well or producing formation

If a producing well is abandoned, date of last production 19

Was permission obtained from the Conservation Division or its agents before plugging was commenced? Yes

Name of Conservation Agent who supervised plugging of this well  
Producing formation Depth to top Bottom Total Depth of Well  
Show depth and thickness of all water, oil and gas formations.

OIL, GAS OR WATER RECORDS

CASING RECORD

FORMATION	CONTENT	FROM	TO	SIZE	PUT IN	PULLED OUT
				8-5/8"	222	None

Describe in detail the manner in which the well was plugged, indicating where the mud fluid was placed and the method or methods used in introducing it into the hold. If cement or other plugs were used, state the character of same and depth placed, from feet to feet for each plug set.

1st plug @ 550' w/70 sx  
2nd plug @ 240' w/20 sx  
3rd plug @ 40' x/10 sx

Surface pipe cut off and steel plate welded in place.

RECEIVED  
STATE CORPORATION COMMISSION  
1-26-1979  
JAN 26 1979

(If additional description is necessary, use BACK of this sheet)

Name of Plugging Contractor Lawbanco Drilling, Inc. CONSERVATION DIVISION  
Wichita, Kansas

STATE OF Oklahoma COUNTY OF Oklahoma, ss.  
Bill Newport, Vice President - Opers (employee of owner) or (owner or operator)  
of the above-described well, being first duly sworn on oath, says: That I have knowledge of the facts, statements, and matters herein contained and the log of the above-described well as filed and that the same are true and correct. So help me God.

(Signature) Bill Newport  
101 Park Avenue, Suite 600, Okla City, Okla  
(Address) 73102

SUBSCRIBED AND SWORN TO before me this 24th day of January, 1979


Mary J. Myers  
Notary Public.

My commission expires Dec. 8, 1982

15-051-21595-00-00

# Lawbanco Drilling, Inc.

P. O. Box 364  
Hill City, Kansas 67642

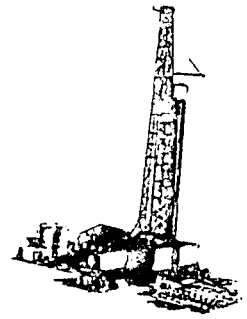

Phone (913) 674-2431

## Drilling Log

OPERATOR: Brooks Hall Oil Corp.  
101 Park Ave., Suite 600  
Oklahoma City, Oklahoma 73102

LEASE: Schmeilder # 1  
NE 1/4 NE/4, 30-12-17  
Ellis County, Kansas

CONTRACTOR: Lawbanco Drilling, Inc.  
P. O. Box 364  
Hill City, Kansas 67642

COMMENCED: 12/8/78

COMPLETED: 12/16/78

RTD: 3820'

SURFACE CASING: 8 5/8" set @ 222' with 170 sx

0-222' 12 1/4" Surface Hole  
222-844 Shale  
844-1035 Sand  
1035-1372 Shale & Lime  
1372-1417 Anhydrite  
1417-1812 Sand & Shale  
1812-3090 Shale & Lime  
3090-3355 Lime & Shale  
3355-3610 Shale & Lime  
3610-3820 Lime & Shale  
3820 RTD

RECEIVED  
STATE CORPORATION COMMISSION  
2-5-1979  
FEB - 5 1979

CONSERVATION DIVISION  
Wichita, Kansas

Lawbanco Drilling, Inc.

*Verlin J. Pfeifer*  
Verlin J. Pfeifer

Vice-Pres.

VJP/dd