

STATE OF KANSAS
STATE CORPORATION COMMISSION

19270
15-051-~~21057~~-00-00
WELL PLUGGING RECORD

Give All Information Completely
Make Required Affidavit
Mail or Deliver Report to:
Conservation Division
State Corporation Commission
800 Bitting Building
Wichita, Kansas

Ellis County, Sec. 30 Twp. 12 Rge. 17 (X) W (W)

Location as "NE/CNW/SW" or footage from lines NE/NW/NW
Lease Owner Michaelis Drilling Co. & Ralph Weaver, Jr.

Lease Name Schmeidler "F" Well No. 1

Office Address 1019 East Second Street

Character of Well (completed as Oil, Gas or Dry Hole) dry hole

Date well completed September 26th 19 55

Application for plugging filed September 26th 19 55

Application for plugging approved September 26th 19 55

Plugging commenced September 26th 19 55

Plugging completed September 26th 19 55

Reason for abandonment of well or producing formation dry

If a producing well is abandoned, date of last production never produced 19

Was permission obtained from the Conservation Division or its agents before plugging was commenced? yes

Name of Conservation Agent who supervised plugging of this well Eldon Petty

Producing formation none Depth to top Bottom 3740 Total Depth of Well 3740 Feet

Show depth and thickness of all water, oil and gas formations.

OIL, GAS OR WATER RECORDS

CASING RECORD

FORMATION	CONTENT	FROM	TO	SIZE	PUT IN	PULLED OUT
Surface	Water	0		8-5/8		none

Describe in detail the manner in which the well was plugged, indicating where the mud fluid was placed and the method or methods used in introducing it into the hole. If cement or other plugs were used, state the character of same and depth placed, from feet to feet for each plug set.

Heavy mud to 100 feet. Plugged @ 190' one-half sax hulls and 15 sax cement. Heavy mud to 40 ft. Wooden plug @ 40'. One-half sax hulls. 10 sax cement to bottom of cellar.

RECEIVED
OCT 29 1955
CONSERVATION DIVISION
WICHITA, KANSAS

(If additional description is necessary, use BACK of this sheet)
Name of Plugging Contractor Garvey Drilling
Address Wichita, Kansas

STATE OF KANSAS COUNTY OF SEDGWICK, ss.
W. A. Michaelis, Jr., (employee of owner) or (owner or operator) of the above-described

well, being first duly sworn on oath, says: That I have knowledge of the facts, statements, and matters herein contained and the log of the above-described well as filed and that the same are true and correct. So help me God.

(Signature) W. A. Michaelis
1019 E. Second St., Wichita 7, Kansas (Address)

SUBSCRIBED AND SWORN TO before me this 5th day of October, 19 55

My commission expires Nov. 7, 1957
Mary L. Barnes Notary Public.

PLUGGING
FILE REC 20 Y 12 R 17 W
BOOK PAGE 5 LINE 26

WELL LOG

^{P270}
15-051-0~~1057~~-00-00

COMPANY MICHAELIS DRILLING COMPANY

SEC. 30 T. 12S R. 17W

FARM Schmeidler 'F' NO. 1


LOC. NE NW NW

TOTAL DEPTH 3740'

COUNTY Ellis

COMM. September 16, 1955 COMP. September 26, 1955

CONTRACTOR GARVEY DRILLING COMPANY

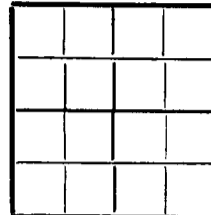

CASING 8-5/8" @ 199 w/140 sax


ELEVATION 2132 DF

PRODUCTION

FIGURES INDICATE BOTTOM OF FORMATIONS

70	Rock & Dirt
115	Clay & Rock
200	Shale & Shells
620	Clay & Shale
665	Sand
860	Shale & Shells
1030	Sand
1376	Shale & Sand
1402	Anhydrite
1515	Shale & Shells
1860	Shale
2320	Shale & Shells
2635	Lime & Shale
2740	Lime & Bentonite
3990	Lime & Shale
3175	Lime
3255	Lime & Shale
3700	Lime
3740	Lime & Conglomerate
3740	T. D.

State of KANSAS }
County of SEDGWICK } ss :

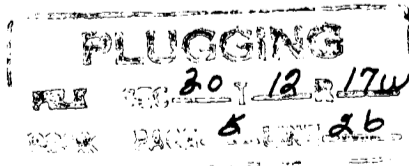

I, Robert F. White of GARVEY DRILLING COMPANY

upon oath state that the above and foregoing is a true and correct copy of the log of the #1 Schmeidler 'F' well

[Signature]
Attorney In Fact

Subscribed and sworn to before me this 6th day of October 1955

My Commission Expires: August 8, 1959

[Signature]
NOTARY PUBLIC