


STATE OF KANSAS
STATE CORPORATION COMMISSION

15-051-21596-00-00
WELL PLUGGING RECORD

Give All Information Completely
Make Required Affidavit
Mail or Deliver Report to
Conservation Division
State Corporation Comm.
245 North Water
Wichita, KS 67202

Ellis County. Sec. 31 Twp. 12S Rge. 17W E/W
Location as "NE/CNW $\frac{1}{4}$ SW $\frac{1}{4}$ " or footage from lines
C SW SE NE

Lease Owner Brooks Hall Oil Corporation
Lease Name Karlin Well No. 1
Office Address 101 Park Avenue, Suite 600, Okla City, Okla
Character of Well (Completed as Oil, Gas or Dry Hole)
Dry Hole
Date Well completed 12-27 19 78
Application for plugging filed 12-28 (Verbal) 19 78
Application for plugging approved 12-28 (Verbal) 19 78
Plugging commenced 12-28 19 78
Plugging completed 12-28 19 78
Reason for abandonment of well or producing formation

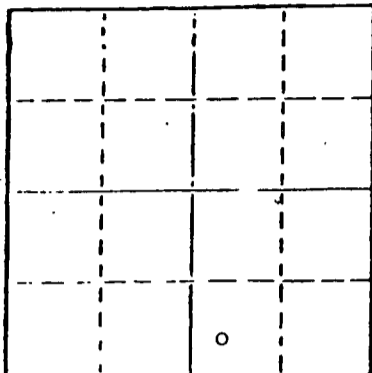

Locate well correctly on above
Section Plat

If a producing well is abandoned, date of last production 19

Was permission obtained from the Conservation Division or
its agents before plugging was commenced?

Name of Conservation Agent who supervised plugging of this well
Producing formation Depth to top Bottom Total Depth of Well
Show depth and thickness of all water, oil and gas formations.

OIL, GAS OR WATER RECORDS

CASING RECORD

FORMATION	CONTENT	FROM	TO	SIZE	PUT IN	PULLED OUT
				8-5/8"	223	None

Describe in detail the manner in which the well was plugged, indicating where the mud fluid
was placed and the method or methods used in introducing it into the hold. If cement or other
plugs were used, state the character of same and depth placed, from feet to
feet for each plug set.

Spotted 70 sx @ 550'

20 sx @ 240'

Placed wooden plug @ 40' w/10 sx cem

Surface pipe cut off and steel plate welded in place.

RECEIVED
STATE CORPORATION COMMISSION
2-5-1979
FEB - 5 1979

(If additional description is necessary, use BACK of this report)
Name of Plugging Contractor Lawbanco Drilling Co., P.O. Box 364, Hill City, Kansas

STATE OF Oklahoma COUNTY OF Oklahoma, ss.
Bill Newport (employee of owner) or (owner or operator)

of the above-described well, being first duly sworn on oath, says: That I have knowledge of
the facts, statements, and matters herein contained and the log of the above-described well
as filed and that the same are true and correct. So help me God.

(Signature)

Bill Newport
101 Park Avenue, Suite 600, Oklahoma City,
(Address) Okla 73102

SUBSCRIBED AND SWORN TO before me this 2nd day of February, 19 79

Mary J. Myers
Notary Public.

My commission expires Dec. 8, 1982


15-051-21596-00-00

Lawbanco Drilling, Inc.

P. O. Box 364
Hill City, Kansas 67642

Phone (913) 674-2431

Drilling Log

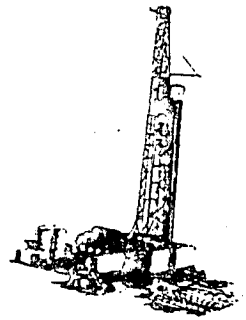

OPERATOR: Brooks Hall Oil Corp.
101 Park Ave., Suite 600
Oklahoma City, Oklahoma 73102

LEASE: Karlin # 1
SW SE/4, NE/4, 31-12-17
Ellis County, Kansas

CONTRACTOR: Lawbanco Drilling, Inc.
P. O. Box 364
Hill City, Kansas 67642

COMMENCED: 12/16/78

COMPLETED: 12/28/78

RTD: 3655'

SURFACE CASING: 8 5/8" set @ 223' with 170 sx

0-225' 12 $\frac{1}{4}$ " Surface Hole
225-485 Shale & Sand
485-810 Shale
810-950 Sand
950-1138 Red Bed
1138-1305 Shale & Lime
1305-1344 Anhydrite
1344-2024 Shale & Lime
2024-2820 Lime & Shale
2820-3400 Shale & Lime
3400-3655 Lime & Shale
3655 RTD

RECEIVED
STATE CORPORATION COMMISSION
Z-5-1979
FEB - 5 1979

CONSERVATION DIVISION
Wichita, Kansas

Lawbanco Drilling, Inc.

Verlin J. Pfeifer
Verlin J. Pfeifer

Vice-Pres.

VJP/dd