


STATE OF KANSAS
STATE CORPORATION COMMISSION

Give All Information Completely
Make Required Affidavit
Mail or Deliver Report to:
Conservation Division
State Corporation Commission
800 Biting Building
Wichita, Kansas

15-051-01244-00-00
WELL PLUGGING RECORD

NORTH

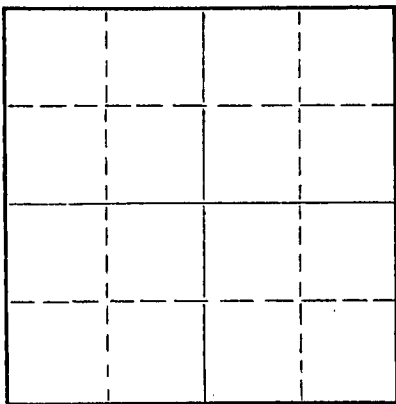

Locate well correctly on above
Section Plat

Ellis County. Sec. 4 Twp. 12 Rge. 19W (E) (W)

Location as "NE/CNW/SW" or footage from lines SW NW SE

Lease Owner Artnell Company

Lease Name Nicholson Well No. 1

Office Address 533 Petroleum Building, Wichita, Kansas

Character of Well (completed as Oil, Gas or Dry Hole) Dry Hole

Date well completed 12/31/59 19

Application for plugging filed 12/31/59 19

Application for plugging approved 12/31/59 19

Plugging commenced 12/31/59 19

Plugging completed 12/31/59 19

Reason for abandonment of well or producing formation

If a producing well is abandoned, date of last production 19

Was permission obtained from the Conservation Division or its agents before plugging was commenced? Yes

Name of Conservation Agent who supervised plugging of this well Elden Petty - Ellis County, Hays, Kansas

Producing formation Depth to top Bottom Total Depth of Well 3725 Feet

Show depth and thickness of all water, oil and gas formations.

OIL, GAS OR WATER RECORDS

CASING RECORD

FORMATION	CONTENT	FROM	TO	SIZE	PUT IN	PULLED OUT
				8-5/8"	245'	None

Describe in detail the manner in which the well was plugged, indicating where the mud fluid was placed and the method or methods used in introducing it into the hole. If cement or other plugs were used, state the character of same and depth placed, from 4763 feet to feet for each plug set.

Filled hole from total depth, 3725, to 600 ft. with mud; cement plug at 600 ft to 200 ft.; cement plug with 15 Sks., 1/4 Sk. Hulls; Mud from 200 ft. to 40 ft.; cement plug with 10 sacks; 1/4 sack hulls; heavy rotary mud to cellar.

RECEIVED
STATE CORP
1-7-1960
JAN 7
CONSERVATION DIVISION
Wichita, Kansas

(If additional description is necessary, use BACK of this sheet)

Name of Plugging Contractor National Drilling Company, Inc.

Address 533 Petroleum Building - Wichita, Kansas

STATE OF Kansas, COUNTY OF Sedgwick, ss.

Donald R. Douglass (employee of owner) or (owner or operator) of the above-described

well, being first duly sworn on oath, says: That I have knowledge of the facts, statements, and matters herein contained and the log of the above-described well as filed and that the same are true and correct. So help me God.

(Signature) Donald R. Douglass

(Address)

SUBSCRIBED AND SWORN to before me this 6 day of January, 19 59

My commission expires 2/24/60

Betty Baker Notary Public.

15-051-01244-00-00

DRILLERS LOG

CASING RECORD:

8-5/8" @ 245'

TOTAL DEPTH:

3725'

COMPANY: Artnell Company
533 Petroleum Bldg.
Wichita, Kansas

CONTRACTOR: Nat'l Drlg. Co.

COMMENCED: 12/22/59

COMPLETED: 12/31/59

DESCRIPTION:

SW NW SE 4-12S-9W
Ellis Co., Kansas

ELEVATION: 2137 DF

FORMATION	FROM	TO
Post Stone	0	70
Blue Shale	70	245
Shale & Sand	245	1220
Shale & Shells	1220	1450
Anhydrite	1450	1495
Shale & Shells	1495	1830
Shale & Lime	1830	2200
Lime & Shale	2200	2435
Lime	2435	2575
Lime	2575	2690
Shale & Shells	2690	2800
Lime & Shale	2800	2960
Shale & Lime	2960	3175
Lime & Shale	3175	3285
Lime	3285	3350
Lime	3350	3450
Lime	3450	3515
Lime	3515	3555
Lime	3555	3571
Lime & Shale	3571	3630
Lime	3630	3680
Lime	3680	3725

STATE CORPORATION DIVISION
JAN 7 - 1960
1960
CONSERVATION DIVISION
Wichita, Kansas

I certify that this is a true and correct copy of the above log to the best of my knowledge.

NATIONAL DRILLING COMPANY, INC.

Howard A. Stoskopf
Howard A. Stoskopf, Vice President

Subscribed and sworn to before me this 6th day of January, 1960.

Betty Baker
Betty Baker, Notary Public

My commission expires: 2/24/60