


STATE OF KANSAS
STATE CORPORATION COMMISSION

Give All Information Completely
Make Required Affidavit
Mail or Deliver Report to:
Conservation Division
State Corporation Commission
211 No. Broadway
Wichita, Kansas

15-051-01284-00-00
WELL PLUGGING RECORD

NORTH

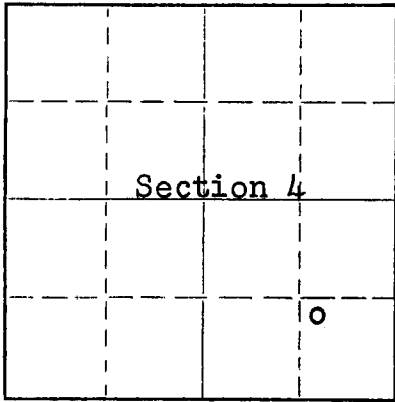

Locate well correctly on above
Section Plat

Ellis County. Sec. 4 Twp. 12 Rge. 19 (E) W (W)
Location as "NE/CNW/SW" or footage from lines NW SE SE
Lease Owner Petroleum, Inc.
Lease Name Nicholson "D" Well No. 1
Office Address Route 2 Great Bend, Kansas
Character of Well (completed as Oil, Gas or Dry Hole) Dry hole
Date well completed July 19 19 57
Application for plugging filed July 19 19 57
Application for plugging approved July 19 19 57
Plugging commenced July 19 19 57
Plugging completed July 20 19 57
Reason for abandonment of well or producing formation No Producing zones

If a producing well is abandoned, date of last production none 19
Was permission obtained from the Conservation Division or its agents before plugging was commenced? Yes

Name of Conservation Agent who supervised plugging of this well Eldon Petty Hays, Kansas
Producing formation --- Depth to top --- Bottom --- Total Depth of Well 3800 Feet
Show depth and thickness of all water, oil and gas formations.

OIL, GAS OR WATER RECORDS

CASING RECORD

FORMATION	CONTENT	FROM	TO	SIZE	PUT IN	PULLED OUT
				8 5/8"	213'	None

Describe in detail the manner in which the well was plugged, indicating where the mud fluid was placed and the method or methods used in introducing it into the hole. If cement or other plugs were used, state the character of same and depth placed, from feet to feet for each plug set.

Mud up with heavy mud to 650' followed by wooden plug. Placed 1/2 sack hulls on top of plug and cemented to base of well cellar with 100 sacks cement, 100 cu. ft. strata-crete, 6% gel.

(If additional description is necessary, use BACK of this sheet)

Name of Plugging Contractor Garvey Drilling Co.
Address Route 2, Great Bend, Kansas

STATE OF KANSAS, COUNTY OF BARTON, ss.
Don Searle (employee of owner) or (owner or operator) of the above-described well, being first duly sworn on oath, says: That I have knowledge of the facts, statements, and matters herein contained and the log of the above-described well as filed and that the same are true and correct. So help me God.

(Signature) Don Searle
Route 2, Great Bend, Kansas (Address)

SUBSCRIBED AND SWORN TO before me this 25th day of July 19 57

My commission expires July 11, 1960

PLUGGING
FILE SEC 4 T 12 R 19W
BOOK PAGE 30 LINE 32

RECEIVED
7-29-1957
JUL 29 1957
CONSERVATION DIVISION
Wichita, Kansas

COMPANY PETROLEUM, INCORPORATED

SEC. 4 T. 12S R. 19W

FARM NICHOLSON "D" NO. 1

LOC. NW, SE, SE


TOTAL DEPTH 3800'

COUNTY Ellis Co., Kansas

COMM. July 10, 1957

COMP. July 20, 1957

CONTRACTOR GARVEY DRILLING COMPANY

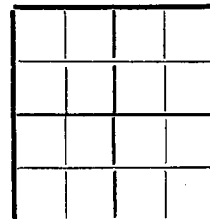

CASING 8 5/8" @ 213' W/150 sax.

ELEVATION 2178' DF

PRODUCTION D & A

FIGURES INDICATE BOTTOM OF FORMATIONS

50	Surface soil & sand
640	Blue shale
950	Sand & streaks pyrite
1280	Red bed & shale
1325	Shale
1375	Sand
1550	Shale & sandy lime
2100	Shale & shells
3085	Lime & shale
3695	Lime
3720	Cherty conglomerate
3750	Sandy conglomerate
3800	Lime
3800	T. D.

State of KANSAS

County of BARTON

PLUGGING
 FILE SEC. 4 T. 12 R. 19W
 BOOK PAGE 30 LINE 32

RECEIVED
 STATE CORPORATION COMMISSION
 7-29-1957
 JUL 29 1957
 CONSERVATION DIVISION
 Wichita, Kansas

I, Verne A. Morris of Garvey Drilling Co.

upon oath state that the above and foregoing is a true and correct copy of the log of the #1 Nicholson "D" well

Verne A. Morris

Subscribed and sworn to before me this 25th day of July 19 57

My Commission Expires: July 11, 1960

Delbert Brown
NOTARY PUBLIC