


STATE OF KANSAS  
STATE CORPORATION COMMISSION

15-051-04592-00-00  
WELL PLUGGING RECORD

Give All Information Completely  
Make Required Affidavit  
Mail or Deliver Report to:  
Conservation Division  
State Corporation Commission  
800 Bittling Building  
Wichita, Kansas

Ellis County. Sec. 15 Twp. 12S Rge. 18 (E) W (W)  
Location as "NE/CNW $\frac{1}{4}$ SW $\frac{1}{4}$ " or footage from lines C West Line SE $\frac{1}{4}$   
Lease Owner Carl Lebsack  
Lease Name Byers Well No. 2  
Office Address Hays, Kansas  
Character of Well (completed as Oil, Gas or Dry Hole) Dry Hole  
Date well completed May 8, 19 50  
Application for plugging filed May 8, 19 50  
Application for plugging approved May 8, 19 50  
Plugging commenced May 8, 19 50  
Plugging completed May 8, 19 50  
Reason for abandonment of well or producing formation too low structurally.

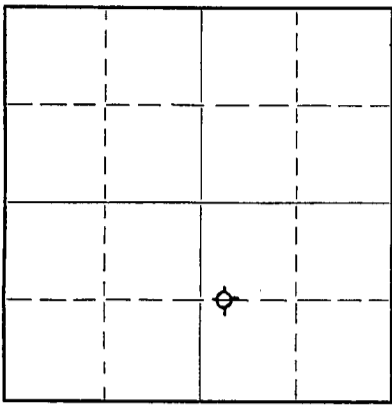

Locate well correctly on above  
Section Plat

If a producing well is abandoned, date of last production 19  
Was permission obtained from the Conservation Division or its agents before plugging was commenced? Yes

Name of Conservation Agent who supervised plugging of this well Eldon Petty, Hays, Kansas  
Producing formation Depth to top Bottom Total Depth of Well Feet  
Show depth and thickness of all water, oil and gas formations.

OIL, GAS OR WATER RECORDS

CASING RECORD

Formation	Content	From	To	Size	Put In	Pulled Out
				8-5/8"	203.60'	

Describe in detail the manner in which the well was plugged, indicating where the mud fluid was placed and the method or methods used in introducing it into the hole. If cement or other plugs were used, state the character of same and depth placed, from feet to feet for each plug set.

Filled with drilling mud to 205'. Drove plug to 203'. Put in 15 sacks cement then pumped full of mud 25' from top of hole. Drove plug down to 25' then filled to top with 10 sacks of cement.

(If additional description is necessary, use BACK of this sheet)

Correspondence regarding this well should be addressed to Carl Lebsack  
Address Hays, Kansas

STATE OF KANSAS, COUNTY OF Sedgwick, ss.  
Carl Lebsack (owner or operator) of the above-described well,  
being first duly sworn on oath, says: That I have knowledge of the facts, statements, and matters herein contained and the log of the above-described well as filed and that the same are true and correct. So help me God.

(Signature) Carl Lebsack

(Address)

SUBSCRIBED AND SWORN to before me this 10th day of May 1950

My commission expires June 25, 1951

Wicky Fritz  
Notary Public.

22-7377-s 4-49-10M

PLUGGING  
FILE SEC-15T 12R 18W  
BOOK PAGE 5 LINE 9

5-18-1950

KANSAS

15051-04597-00-00  
CONTRACTOR'S WELL LOG

RECEIVED  
6-3-1950  
JUN 3 1950  
STATE COMMISSION

Operator Carl Lebsack Farm Name Byers #2

Location C West Line SE 1/4 Sec. 15-12S-18W.

Pool Name Koblitz County Ellis State Kansas

LOG OF WELL

Elevation 2177' D.F.  
All measurements from the top of rotary bushing.

DEPTH FROM	TO	FORMATION	DEVIATION FROM VERTICAL	REMARKS:
0	203			
203	505	Shale		
505	720	Sand		
720	920	Shale-Shells-Sand		
920	1098	Sand		
1098	1220	Shale-Shells		
1220	1250	Red Bed		
1250	1444	Red Bed		
1444	1479	Anhydrite		
1479	1490	Shale-Shells		
1490	1770	Shale-Shells	1500' - 0°	
1770	1840	Salt		
1840	2005	Salt		
2005	2080	Shale-Lime	2000' - 0°	
2080	2150	Shale-Lime		
2150	2270	Shale		
2270	2400	Shale-Lime		
2400	2460	Shale-Lime		
2460	2560	Shale-Lime		
2560	2675	Shale-Lime		
2675	2760	Lime-Shale		
2760	2825	Lime-Shale		
2825	2930	Lime-Shale		
2930	3040	Shale-Lime		
3040	3145	Lime-Shale		
3145	3220	Lime-Shale		
3220	3245	Shale		
3245	3295	Lime-Shale		
3295	3350	Lime-Shale	3400' - 0°	
3350	3410	Shale-Lime		
3410	3460	Lime		
3460	3500	Lime		
3500	3570	Lime		
3570	3640	Lime		
3640	3700	Lime		
3700	3726	Lime		

Commencement Date April 28, 1950 Completion Date May 8, 1950

CASING LEFT IN HOLE AFTER COMPLETION

Set 203.60' (8 jts.) 8-5/8" OD Casing:

STATE OF KANSAS, COUNTY OF SEDGWICK ) ss.

The undersigned certifies that to the best of his knowledge and belief, the above facts are true and correct.

C-G DRILLING COMPANY, Inc.  
By R. A. Cook, President

Subscribed and sworn to before me this 9th day of May, 1950.

My commission expires:  
June 25, 1951

Wick Lutz  
Notary Public

