


STATE OF KANSAS  
STATE CORPORATION COMMISSION

Give All Information Completely  
Make Required Affidavit  
Mail or Deliver Report to:  
Conservation Division  
State Corporation Commission  
212 North Market, Insurance Bldg.  
Wichita, Kansas

**WELL PLUGGING RECORD**  
15-051-05124-00-00

Ellis County, Sec. 15 Twp. 12 Rge. 18 (E) (W)W

Location as "NE/CNW/SW" or footage from lines SE Sw NW  
Lease Owner C & G Drilling Co.  
Lease Name Baker Well No. 1  
Office Address Wichita, Kansas  
Character of Well (completed as Oil, Gas or Dry Hole) Oil  
Date well completed 6/27/60 19\_\_  
Application for plugging filed 6/27/60 19\_\_  
Application for plugging approved 6/27/60 19\_\_  
Plugging commenced 6/25/60 19\_\_  
Plugging completed 6/27/60 19\_\_  
Reason for abandonment of well or producing formation No longer commercial

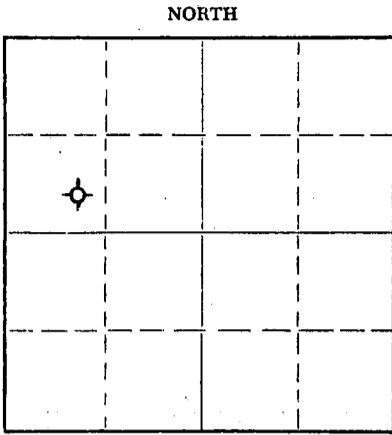

Locate well correctly on above  
Section Plat

If a producing well is abandoned, date of last production February 12 19 60  
Was permission obtained from the Conservation Division or its agents before plugging was commenced? Yes

Name of Conservation Agent who supervised plugging of this well Eldon Petty  
Producing formation plugged back to Lansing Depth to top 3345 Bottom 3350 <sup>Old</sup> Total Depth of Well 3721 Feet  
Show depth and thickness of all water, oil and gas formations.

OIL, GAS OR WATER RECORDS

CASING RECORD

FORMATION	CONTENT	FROM	TO	SIZE	PUT IN	PULLED OUT
				8-5/8	178'	None
				5-1/2	3714'	None

Describe in detail the manner in which the well was plugged, indicating where the mud fluid was placed and the method or methods used in introducing it into the hole. If cement or other plugs were used, state the character of same and depth placed, from \_\_\_\_\_ feet to \_\_\_\_\_ feet for each plug set.

Plugged back to 3330 ft. with sand and dumped 4 sacks cement.  
Couldn't get any pipe pumped in 20 sacks of mud and 70 sacks cement.

**RECEIVED**  
STATE CORPORATION COMMISSION  
7-14-1960  
JUL 14 1960  
CONSERVATION DIVISION  
Wichita, Kansas

(If additional description is necessary, use BACK of this sheet)  
Name of Plugging Contractor Central Pipe Pulling Co.  
Address 1416 Coolidge, Great Bend, Kansas

STATE OF KANSAS, COUNTY OF SEDGWICK, ss.  
G. F. Galloway (~~employee of owner~~) or (owner or operator) of the above-described well, being first duly sworn on oath, says: That I have knowledge of the facts, statements, and matters herein contained and the log of the above-described well as filed and that the same are true and correct. So help me God.

(Signature) G. F. Galloway  
107 Rule Building  
(Address)

SUBSCRIBED AND SWORN to before me this 12th day of July, 19 60

My commission expires May 20, 1963  
Vicky Jacobs  
Notary Public.



15-051-05124-00-00

COPY


WELL LOG BUREAU - KANSAS GEOLOGICAL SOCIETY  
508 East Murdock, Wichita, Kansas

Company. C-G DRILLING CO. & HOLLY OIL CO.  
Farm. Baker No. 1

SEC. 15 T. 12 R. 18W  
SE SW NW

Total Depth. 3717  
Comm. 9-14-54  
Shot or Treater.  
Contractor. C-G Drilling Co.  
Issued. 12-25-54

County Ellis  
KANSAS

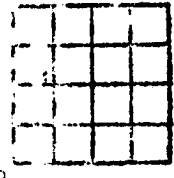

Elev. 2125 RB

Production. 36 bbls.

CASING:

8 5/8 178.79  
5 1/2 3730.46

Figures indicate bottom of formation

shale & shells	610
sand	710
shale & shells	970
sand	1100
shale & shells	1935
lime & shale	3355
lime	3356
lime & shale	3480
lime	3601
lime & shale	3717
Total Depth	

TOPS:

Topeka	3143
Heebner	3385
Toronto	3405
Kansas City	3431
Arbuckle	3712

DST #1: 3177-3285  
DST #2: 3342-56  
DST #3: 3342-56  
DST #4: 3464-80

All Meas. from top of rotary bushing

RECEIVED  
STATE CORPORATION COMMISSION  
7-16-1964  
JUL 16 1964  
CONSERVATION DIVISION  
Wichita, Kansas