


Give All Information Completely
Make Required Affidavit
Mail or Deliver Report to:
Conservation Division
State Corporation Commission
211 No. Broadway
Wichita, Kansas

15-051-04007-00-00
WELL PLUGGING RECORD

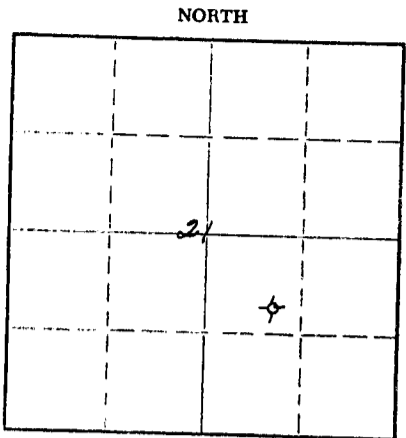

Locate well correctly on above Section Plat

Ellis County, Sec. 21 Twp. 12S Rge. 18 (X) X (W)
Location as "NE/CNWKS" or footage from lines SE NW SE
Lease Owner E.K. Carey Drlg. Co. & Mayfield-Smith Drlg, Inc.
Lease Name Madden Well No. 1
Office Address 928 Union Center Bldg., Wichita 2, Kansas
Character of Well (completed as Oil, Gas or Dry Hole) Dry Hole
Date well completed November 3 19 62
Application for plugging filed " 19 62
Application for plugging approved " 19 62
Plugging commenced " 19 62
Plugging completed " 19 62
Reason for abandonment of well or producing formation
Oil in commercial quantities not found.
If a producing well is abandoned, date of last production - - - 19 - - -
Was permission obtained from the Conservation Division or its agents before plugging was commenced? Yes

Name of Conservation Agent who supervised plugging of this well Eldon Petty, Hays, Kansas
Producing formation - - - Depth to top - - - Bottom - - - Total Depth of Well 3695 Feet
Show depth and thickness of all water, oil and gas formations.

OIL, GAS OR WATER RECORDS

CASING RECORD

FORMATION	CONTENT	FROM	TO	SIZE	PUT IN	PULLED OUT
				8 5/8"	251'	None

Describe in detail the manner in which the well was plugged, indicating where the mud fluid was placed and the method or methods used in introducing it into the hole. If cement or other plugs were used, state the character of same and depth placed, from - - - feet to - - - feet for each plug set.

Filled hole to 540' with heavy rotary mud.
Set #1 Plug @ 540' W/20 Sks. Cement, through drill pipe.
Set #2 Plug @ 240' W/20 Sks. Cement through drill pipe.
Set top plug @ 40', filled with cement to base of cellar.

11-19-1962

CONSERVATION DIVISION
Wichita, Kansas

Name of Plugging Contractor Mayfield-Smith Drilling, Inc. (If additional description is necessary, use BACK of this sheet)
Address 928 Union Center Bldg., Wichita, Kansas.

STATE OF KANSAS COUNTY OF SEDGWICK ss.
Charles R. Mayfield (employee of owner) or (owner or operator) of the above-described well, being first duly sworn on oath, says: That I have knowledge of the facts, statements, and matters herein contained and the log of the above-described well as filed and that the same are true and correct. So help me God.

(Signature) Charles R. Mayfield
928 Union Center Bldg., Wichita, Kansas (Address)

SUBSCRIBED AND SWORN to before me this 12th day of November, 19 62
My commission expires 10-26-65

Arguente Mayfield
Notary Public.



15-051-04607-00-00

MAYFIELD-SMITH DRILLING, INC.
Union Center Bldg.
Wichita, Kansas

RECEIVED
11-19-1962

CONSERVATION DIVISION
Wichita, Kansas

DRILLERS LOG

#1 Madden
SE NW SE Sec. 21-12S-18W
Ellis County, Kansas

Date Started: October 26, 1962
Date Completed: November 3, 1962
Casing: Set 251' of 8 5/8" W/145 Sx.

TOPS

0 - 125	Rock & Clay	Elevation: 2139	Kelly Bushing
125 - 560	Blue Shale		
560 - 620	Sand	Anhydrite	1420
620 - 690	Shale	Topeka	3123
690 - 770	Blue & Grey Shale	Heebner	3367
770 - 820	Shale	Toronto	3387
820 - 1100	Sand	Lansing	3412
1100 - 1420	Red Bed	Arbuckle	3681
1420 - 1445	Anhydrite	Total Depth	3695
1445 - 1481	Lime & Shale		
1481 - 1740	Shale & Shells		
1740 - 3171	Shale & Lime		
3171 - 3622	Lime		
3622 - 3695	Lime & Shale		

AFFIDAVIT

State of Kansas)
) SS
County of Sedgwick)

I, Charles R. Mayfield, do hereby certify that the above and foregoing is a true and correct Log of the #1 Madden, located in the SE NW SE of Section 21, Township 12 South, Range 18 West, Ellis County, Kansas, as reflected by the Daily Drilling Reports of Mayfield-Smith Drilling, Inc.

Charles R. Mayfield
Charles R. Mayfield

State of Kansas)
) SS
County of Sedgwick)

Subscribed and sworn to before me, a Notary Public, in and for Sedgwick County, Kansas, this 12th day of November, 1962.

Marguerite Mayfield
Notary Public

My Commission Expires: 10-26-65