


15-163-02170-0000

WELL RECORD

(Kansas)

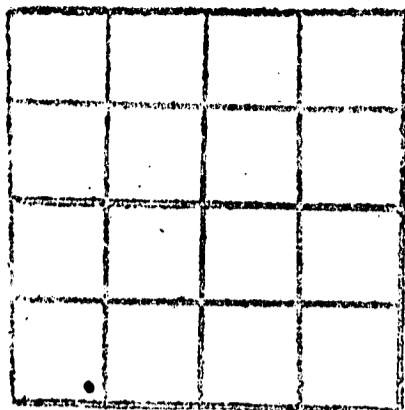

RCWD
09-18-47

County Rooks Sec. 15 Twp. 10S R. 20W

Company Operation: Champlin Refining Co.

Office Address Enid, Oklahoma

Well Name Marotte Well No. 5

Well Located 990' from W. line & 330'
from the S. line of Sec. 15

Character of Well Oil

Drilling started: 8/22/47

Drilling completed: 9/10/47

CLOGGING RECORD

Size	Wt. This	ft.	Amount Pulled	Comments
10- 3/4" 28#	O.D.	160'		125 sacks
7" O.D. 23#	8R	4168'		350 sacks

FORMATION RECORD

Formation	Top	Bottom	Formation	Top	Bottom
Shale	0	465			
Shale, Shells & sand	465	1110			
Lime & Shale	1110	2180			
Lime & Shale	2180	3275			
Lime	3275	3465			
Lime & shale	3465	3515			
Lime	3515	4198 T.D.			

FORMATION TOPS

Top, Topeka	3160
Top, Lansing	3389
Base, Pennsylvanian	3660
Top, Arbuckle (Weathered)	3660
Top, Arbuckle	3663

D. F. 2129.

Subscribed and sworn to before me this 18th day of Sept., 1947.

Jerry Gober
Notary Public.

J. C. Wentworth
Superintendent.

My Commission Expires: May 19, 1951