

15-163-00227-0000


STATE OF KANSAS
STATE CORPORATION COMMISSION

WELL PLUGGING RECORD

Give All Information Completely
Make Required Affidavit
Mail or Deliver Report to:
Conservation Division
State Corporation Commission
800 Bitting Building
Wichita, Kansas

Rooks County, Sec. 13 Twp. 10 Rge. 20W
Location as "NE/CNW/SW" or footage from lines SE SE SW
Lease Owner Glenn R. Nye Drilling Co.
Lease Name Sutor Well No. 1
Office Address Hays, Kansas
Character of Well (completed as Oil, Gas or Dry Hole) Oil
Date well completed May 27, 1947 19
Application for plugging filed 1/24/53 19
Application for plugging approved 1/25/53 19
Plugging commenced 1/25/53 19
Plugging completed 1/28/53 19
Reason for abandonment of well or producing formation well depleted

NORTH

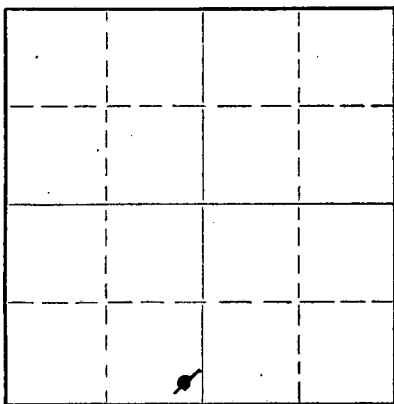

Locate well correctly on above
Section Plat

If a producing well is abandoned, date of last production 1/20/53 19
Was permission obtained from the Conservation Division or its agents before plugging was commenced? yes

Name of Conservation Agent who supervised plugging of this well Eldon Petty
Producing formation Arbuckle dolomite Depth to top 3744 Bottom 3756 Total Depth of Well 3756 Feet
Show depth and thickness of all water, oil and gas formations.

OIL, GAS OR WATER RECORDS

CASING RECORD

FORMATION	CONTENT	FROM	TO	SIZE	PUT IN	PULLED OUT
Surface				8-5/8"	281'	cemented
Arbuckle dolo.	oil	3744	3756	5 1/2"	3745'	993'

Describe in detail the manner in which the well was plugged, indicating where the mud fluid was placed and the method or methods used in introducing it into the hole. If cement or other plugs were used, state the character of same and depth placed, from _____ feet to _____ feet for each plug set.

Plugging Material used

Plugged back: 3755 to 3735 feet	sand
3735 to 3710	5 sks cement
3710 to 280	mud
280 to 270	rod
270 to 210	20 sacks of cement
210 to 30	mud
30 to cellar	10 sacks cement

(If additional description is necessary, use BACK of this sheet)


Name of Plugging Contractor R & S Pipe pulling Company
Address Ellinwood, Kansas

STATE OF Ellis, COUNTY OF Kansas, ss.
E. DeWitt Doley (employee of owner) or (owner/operator) of the above-described well, being first duly sworn on oath, says: That I have knowledge of the facts, statements, and matters herein contained and the log of the above-described well as filed and that the same are true and correct. So help me God.

(Signature) E. DeWitt Doley
Hays, Kansas (Address)

SUBSCRIBED AND SWORN TO before me this 16th day of February, 19 53

John L. Spriggs
Notary Public.

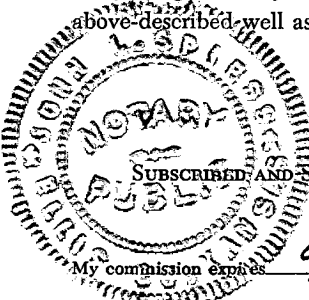

PLUGGING
FILE SEC 13-10 R-204
BOOK PAGE 26-122-44

24-2675-S 2-52-20M
FEB 16 1953
CONSERVATION DIVISION
Wichita, Kansas

Company: Glenn R. Nye Drilling Company et al
Contractor: Glenn R. Nye Drilling Co.
Commenced: May 11, 1949
Completed: May 27, 1949

Farm: Sutor No. 1
Location: SE SE SW 13-10-20W
Rooks County, Kansas
Casing Record: 8 5/8" set at 281'
5 1/2" set at 3745'

(Figures below indicate bottoms)

surface soil and sand	70
sand shale	281
shale	700
shale & streaks iron - pyrite	975
shale shells sand	1200
sand	1315
shale red beds	1560
shale - shells - red bed	1600
anhydrite	1645
shale - shells	1770
shale & shells	1930
shale shells salt	2110
shale lime	2160
shale - lime	2210
lime	2235
lime - shale	2265
lime - shale	2325
shale - lime	2340
shale & shells	2350
shale lime	2440
lime shale	2485
lime - broken	2555
shale - lime	2575
shale - lime	2755
lime shale	2820
lime - shale	2845
shale - shells	2905
lime	2920
lime - shale	2930
lime - shale	2950
shale - lime	3070
shale lime	3155
shale lime	3192
lime	3230
lime & shale	3300
lime shale	3340
lime - streaks of chert	3365
lime	3430
lime traces of iron pyrite	
chert streaks	3460
lime - hard	3475
lime streaks of iron pyrite	3535
lime - hard	3565
lime chert streaks	3585
lime	3606
lime	3645
lime	3690
lime & shale	3705
lime - cherty	3720
lime & shale	3735
lime	3746T.D.
drilled with cable tools to	3748
drilled with cable tools to	3756

PLUGGING
FILE SEC 13 T 10 R 2024
BOOK PAGE 76 LINE 4

top of Arbuckle 3744'

I hereby certify that this is a true and correct log of the above described well as shown by the drilling reports.

Glenn R. Nye Drilling Company
by DeWitt Daley

State of Kansas)
) SS
Ellis County)

Subscribed and sworn to before me, a Notary Public, in and for said County and State this 14th day of Feb, 1949.
1953

My Commission Expires, May 9, 1953

John L. Spiess
Notary Public