


15-163-03402-0000

STATE OF KANSAS
STATE CORPORATION COMMISSION

WELL PLUGGING RECORD

Give All Information Completely
Make Required Affidavit
Mail or Deliver Report to:
Conservation Division
State Corporation Commission
800 Bitting Building
Wichita, Kansas

NORTH

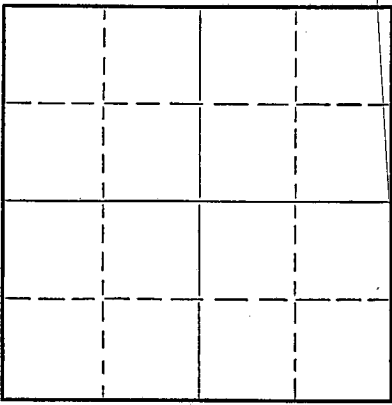

Locate well correctly on above
Section Flat

Rooks County, Sec. 13 Twp. 10 Rge. 20 (W)

Location as "NE/CNW $\frac{1}{4}$ SW $\frac{1}{4}$ " or footage from lines C. N/2 NW NW

Lease Owner Petroleum, Inc.

Lease Name Sutor Well No. 5

Office Address 100 Derby Bldg., Wichita 2, Kansas

Character of Well (completed as Oil, Gas or Dry Hole) Dry Hole

Date well completed September 17, 1951 19 51

Application for plugging filed September 17, 19 51

Application for plugging approved September 20, 19 51

Plugging commenced September 17, 19 51

Plugging completed September 17, 19 51

Reason for abandonment of well or producing formation Dry Hole

If a producing well is abandoned, date of last production 19

Was permission obtained from the Conservation Division or its agents before plugging was commenced? Yes

Name of Conservation Agent who supervised plugging of this well Mr. Eldon Petty

Producing formation Depth to top Bottom Total Depth of Well 3762 Feet

Show depth and thickness of all water, oil and gas formations.

OIL, GAS OR WATER RECORDS

CASING RECORD

Formation	Content	From	To	Size	Put In	Pulled Out
				8 5/8"	296'	None

Describe in detail the manner in which the well was plugged, indicating where the mud fluid was placed and the method or methods used in introducing it into the hole. If cement or other plugs were used, state the character of same and depth placed, from feet to feet for each plug set.

Wooden plug set at 270'. Cemented with 15 sax cement. Filled hole with heavy mud to 40'. Placed wooden plug at 40'. Filled hole to bottom of cellar with 10 sax cement.

SEP 22 1951
CONSERVATION DIVISION
Wichita

(If additional description is necessary, use BACK of this sheet)

Correspondence regarding this well should be addressed to Petroleum, Inc.
Address 100 Derby Bldg., Wichita, Kansas

STATE OF KANSAS, COUNTY OF SEDGWICK, ss.

W. W. Fisher (employee of owner) of the above-described well, being first duly sworn on oath, says: That I have knowledge of the facts, statements, and matters herein contained and the log of the above-described well as filed and that the same are true and correct. So help me God.

(Signature) WW Fisher

100 Derby Bldg., Wichita, Kansas (Address)

Subscribed and sworn to before me this 21st day of September, 1951.

Charlotte Heidman Notary Public.

My commission expires October 13, 1954

28-5091-s 8-50-10M



PLUGGING
FILE SEC 13 T 10 R 20W
BOOK PAGE 110 LINE 32

15-163-03402-0000

WELL LOG SUTOR #5

Petroleum, Inc., Lease Owner
Glenn Nye Drilling, Contractor
Commenced: September 6, 1951
Completed: September 16, 1951
Casing: 296' of 8 5/8" w/175 sax
Production: D & A

Section 13, Twp. 10S, Rge. 20W
Location: C. N/2 NW NE
County: Rooks, Kansas
Rotary Total Depth: 3762'
Elevation: 2185 R.B.

All figures below indicate bottom of formation:

296	Sand & Shale		
432	Shale		
690	Blue Shale	3403	Heebner
785	Shale & Sand	3443	Lansing
845	Sand	3660	B.K.C.
1080	Shale & Pyrite	3699	Conglomerate
1310	Sand		
1535	Red Bed & Shale		
1615	Shale		
1647	Anhydrite		
1675	Shale		
1995	Shale & Shells		
2020	Shale & Salt		
2130	Shale		
2535	Shale & Lime		
2590	Lime		
3459	Lime & Shale		
3491	Lime		
3523	Lime & Shale		
3542	Lime		
3565	Cherty Lime		
3576	Lime & Shale		
3690	Lime		
3762	Conglomerate		
3762'	R.T.D.		

I hereby certify that this is a true and correct log of the above mentioned well.

PETROLEUM, INC.

PLUGGING
FILE SEC 13 T 10 R 20W BY
BOOK PAGE 110 LINE 32

Eric H. Jager
Eric H. Jager

STATE OF KANSAS)
COUNTY OF (SEDGWICK)



Subscribed to and sworn to before me, a Notary Public, in said County and State, this 20th day of September, 1951.

My commission expires: October 13, 1954

Charlotte Weisman
Notary Public