

15-167-02143-0000

RECEIVED
STATE CORPORATION COMMISSION

AUG 30 1972 08-30-72


CONSERVATION DIVISION Form CP-4
Wichita, Kansas

STATE OF KANSAS
STATE CORPORATION COMMISSION

Give All Information Completely
Make Required Affidavit
Mail or Deliver Report to:
Conservation Division
State Corporation Commission

P. O. Box 17027
Wichita, Kansas 67217
NORTH

WELL PLUGGING RECORD

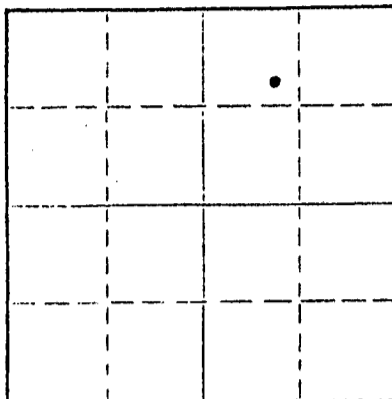

Locate well correctly on above
Section Plat

Rooks County, Sec. 15 Twp. 10S Rge. (E) 20 (W)

Location as "NE/CNW/SE" or footage from lines. SE NW NE

Lease Owner Champlin Petroleum Company

Lease Name Brueggeman Well No. 3

Office Address 2915 N. Lincoln, Okla. City, Okla. 73105

Character of Well (completed as Oil, Gas or Dry Hole) Oil

Date well completed 4-14 19 49

Application for plugging filed 7-12 19 72

Application for plugging approved 7-14 19 72

Plugging commenced 8-18 19 72

Plugging completed 8-18 19 72

Reason for abandonment of well or producing formation Production depleted to
uneconomical limit

If a producing well is abandoned, date of last production 12-17 19 70

Was permission obtained from the Conservation Division or its agents before plugging was com-
menced? Yes

Name of Conservation Agent who supervised plugging of this well Leo Massey, Box 582, Hays, Kansas

Producing formation Arbuckle Depth to top 3750 Bottom 3760 Total Depth of Well 3760 Feet

Show depth and thickness of all water, oil and gas formations.

OIL, GAS OR WATER RECORDS

CASING RECORD

FORMATION	CONTENT	FROM	TO	SIZE	PUT IN	PULLED OUT
Arbuckle	Oil	3750	3760	8-5/8"	186	None
				5 1/2"	3754	None

Describe in detail the manner in which the well was plugged, indicating where the mud fluid was placed and the method or methods used in introducing it into the hole. If cement or other plugs were used, state the character of same and depth placed, from _____ feet to _____ feet for each plug set.

Tubing and rods sanded in hole. Mixed and pumped 10 sacks of Halliburton light cement down 2-7/8" tubing, filling from 630 to surface. Mixed and pumped 3 sacks of hulls and 30 sacks of gel, followed by 105 sacks of Halliburton light cement down 5 1/2" casing filling from 2000 to surface. Mixed and pumped 5 sacks of Halliburton light cement in annulus between 8-5/8" surface casing and 5 1/2" casing filling from 55' to surface.
Well Plugged and Abandoned at 2:30 P.M. on 8-18-72.

(If additional description is necessary, use BACK of this sheet)

Name of Plugging Contractor Plainville Oil Well Service
Address 8th and Main, Plainville, Kansas


STATE OF Oklahoma COUNTY OF Oklahoma, ss.
Harold E. Melvin (employee of owner) or (~~owner or operator~~) of the above-described well, being first duly sworn on oath, says: That I have knowledge of the facts, statements, and matters herein contained and the log of the above-described well as filed and that the same are true and correct. So help me God.

(Signature) Harold E. Melvin
2915 N. Lincoln, Okla. City, Okla. 73105
(Address)

SUBSCRIBED AND SWORN TO before me this 29th day of August, 19 72

My commission expires 10-8-75

Myra A. Owens
Notary Public.

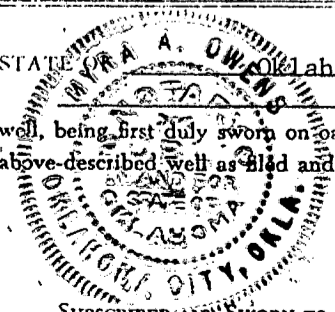

15-163-02143-0000

Champlin Refining Co.
Brueggeman #3

Sec. 15 Twp. 10 Rge. 20
Rooks County, Kansas

Total Depth: 3760'
Comm: 3/28/49
Comp: 4/14/49

Casing
8 5/8" Set at 186'
5 1/2" Set @ 3754'

Cement
130 Sacks
125 Sacks

Formation:	Depth:
Surface Sand	40'
Sand & Shale	75
Shale & Shell	125
Shale & Shell	250
Sand & Shale	300
Shale & Shell	730
Sand, Shale & Red Bed	825
Sand	970
Shale & Sand	1020
Shale, Shells, Pt. Iron	1070
Red Bed, Shale & Shells	1145
Red Bed, Sand & Shale	1335
Shale & Shells	1530
Red Bed & Sand	1670
Anhydrite	1705
Shale & Shell	1780
Red Bed, Shale & Shells	2055
Shale & Shells	2190
Shale & Lime	3500
Lime	3755
Arbuckle	3760

RECEIVED
STATE CORPORATION COMMISSION
JUL 14 1972
CONSERVATION DIVISION
Wichita, Kansas

STATE OF KANSAS)
RUSSELL COUNTY)

I hereby certify that the above information is true and correct
to the best of my knowledge.

Subscribed and sworn to before me this 20th day of April, 1949.

[Signature]
Notary Public

My Comm. Expires 6/17/50