


STATE OF KANSAS
STATE CORPORATION COMMISSION

15-051-01308-00-00
WELL PLUGGING RECORD

Give All Information Completely
Make Required Affidavit
Mail or Deliver Report to:
Conservation Division
State Corporation Commission
212 North Market, Insurance Bldg.
Wichita, Kansas

NORTH

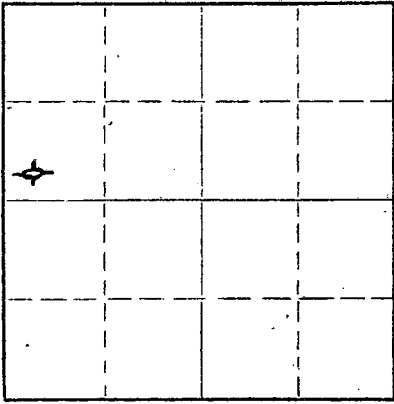

Locate well correctly on above
Section Plat

Ellis County, Sec. 4 Twp. 12 Rge. 18 (E) (W) W
Location as "NE/CNW/SW" or footage from lines SW SW NW
Lease Owner D. G. Hansen
Lease Name Schemer Well No. 1
Office Address Logan, Kansas
Character of Well (completed as Oil, Gas or Dry Hole) Dry Hole
Date well completed February 23 19 61
Application for plugging filed February 23 19 61
Application for plugging approved February 23 19 61
Plugging commenced February 23 19 61
Plugging completed February 23 19 61
Reason for abandonment of well or producing formation Too low structurally

If a producing well is abandoned, date of last production 19
Was permission obtained from the Conservation Division or its agents before plugging was commenced? Yes

Name of Conservation Agent who supervised plugging of this well Eldon Petty, Hays, Kansas
Producing formation Depth to top Bottom Total Depth of Well 3684 Feet
Show depth and thickness of all water, oil and gas formations.

OIL, GAS OR WATER RECORDS

CASING RECORD

FORMATION	CONTENT	FROM	TO	SIZE	PUT IN	PULLED OUT
				8-5/8"	183.89'	None

Describe in detail the manner in which the well was plugged, indicating where the mud fluid was placed and the method or methods used in introducing it into the hole. If cement or other plugs were used, state the character of same and depth placed, from feet to feet for each plug set.

Filled hole with heavy mud to 550'. Set plug. Put in 20 sacks cement. Filled to 180'. Set plug. Put in 1/2 sack hulls and 20 sacks cement. Filled with heavy mud up to 35'. Set plug. Filled to top with 1/2 sack hulls and 10 sacks cement.

RECEIVED
STATE CORPORATION COMMISSION

3-20-1961
MAR 2 1961

RECEIVED

MAR 7 1961

CONSERVATION DIVISION
Wichita, Kansas

A. G. CUMMINGS

(If additional description is necessary, use BACK of this sheet)

Name of Plugging Contractor C-G Drilling Co.
Address 107 Rule Building, Wichita 2, Kansas

STATE OF KANSAS, COUNTY OF SEDGWICK, ss.
G. F. Galloway (employee of owner) or (owner or operator) of the above-described

well, being first duly sworn on oath, says: That I have knowledge of the facts, statements, and matters herein contained and the log of the above-described well as filed and that the same are true and correct. So help me God.

(Signature)

Jay H. Galloway

(Address)

107 Rule Building


SUBSCRIBED AND SWORN TO before me this 6th day of March, 19 61

My commission expires

May 20, 1963

Vicky Jacobs

Notary Public.

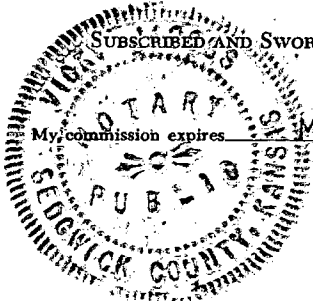

15-051-01308-00-00

WELL LOG

OPERATOR D. G. Hansen SEC. 4-12-18W
 WELL NAME Schemer LOC. SW SW NW
 TOTAL DEPTH 3684' COUNTY Ellis
 COMM. February 14, 1961 COMP. February 23, 1961 STATE Kansas
 RIG NO. 1 ELEVATION 2089' K.B.
 CASING: Ran 183.89' (9 jts.) 8-5/8" OD Surface Casing. PRODUCTION: D & A

All measurements taken from the top of rotary bushing.

FROM	TO	FORMATION	DEVIATION FROM VERTICAL	REMARKS:
0	715	Shale		
715	830	Sand & Shale		
830	1060	Sand		
1060	1395	Red Bed		
1395	1433	Anhydrite		
1433	1505	Shale & Shells		
1505	1950	Shale & Shell		
1950	2600	Shale & Lime	0° - 2500	
2600	2700	Lime & Shale	0° - 2750	
2700	3014	Shale & Lime	0° - 3000	
3014	3203	Lime & Shale	0° - 3250	
3203	3304	Lime		
3304	3364	Lime & Shale		
3364	3508	Lime	0° - 3500	
3508	3566	Lime & Shale		
3566	3680	Lime		
3680	3684	Lime & Shale		DST 3677-3684'

RECEIVED

MAR 7 1961

A. G. CUMMINGS

RECEIVED
 STATE CORPORATION COMMISSION
 3-20-1961
 MAR 20 1961

CONSERVATION DIVISION
 Wichita, Kansas

STATE OF KANSAS

COUNTY OF SEDGWICK

SS.

The undersigned hereby certifies that to the best of his knowledge and belief, the above facts are true and correct.

C-G DRILLING CO.

By

Jay H. Galloway

SUBSCRIBED AND SWORN TO, BEFORE ME, THIS 27th day of February, 1961.

My commission expires:
 May 20, 1963

Vicky Jacobs - Notary public