


Give All Information Completely
Make Required Affidavit
Mail or Deliver Report to:
Conservation Division
State Corporation Commission
800 Bitting Building
Wichita, Kansas

OR
FORMATION PLUGGING RECORD

Strike out upper line
when reporting plug-
ging of formations.

NORTH

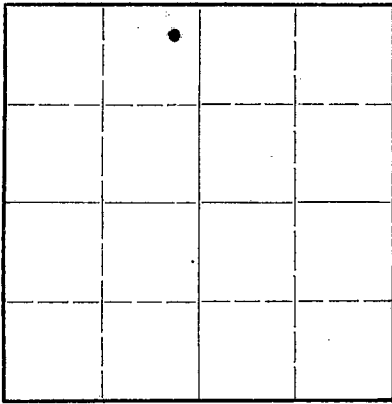

Locate well correctly on above
Section Plat

Ellis County. Sec. 4 Twp. 12S Rge. (E) 18 (W)
Location as "NE 1/4 NW 1/4 SW 1/4" or footage from lines. NE 1/4 NE 1/4 NW 1/4
Lease Owner. Darby & Bothwell, Inc.
Lease Name. Schermer Well No. 1
Office Address. 2003 Philtower Bldg., Tulsa, 3, Oklahoma.
Character of Well (completed as Oil, Gas or Dry Hole). Dry Hole.
Date well completed. August 20, 1947. 19
Application for plugging filed. August 20, 1947. 19
Application for plugging approved. August 21, 1947. 19
Plugging commenced. August 27, 1947. 19
Plugging completed. September 1, 1947. 19
Reason for abandonment of well or producing formation. Dry and abandoned.

If a producing well is abandoned, date of last production. 19
Was permission obtained from the Conservation Division or its agents before plugging was com-
menced? Yes.

Name of Conservation Agent who supervised plugging of this well. C. D. Stough, Hays, Kansas.
Producing formation. Depth to top. Bottom. Total Depth of Well. 3661 Feet
Show depth and thickness of all water, oil and gas formations.

OIL, GAS OR WATER RECORDS

CASING RECORD

Formation	Content	From	To	Size	Put In	Pulled Out
Arbuckle	None	3646	3661	13 3/8"	138'	None
Simpson	"	3638		5 1/2"	3614'	2626'
Conglomerate	"	3634				
K C - Lansing	Oil & water	3337				


Describe in detail the manner in which the well was plugged; indicating where the mud fluid was placed and the method or methods used in introducing it into the hold. If cement or other plugs were used, state the character of same and depth placed, from feet to feet for each plug set.

Filled hole with sand from total depth to 3365', dumped 4 sacks cement, shot offpipe at 2600', pulled pipe and filled hole with heavy mud to 135', put in 10' rock bridge, dumped 25 sacks cement, filled hole with mud to 15', dumped 10 sacks cement for cap. Tore down and moved out.

(SEE REVERSE SIDE FOR WELL LOG)

(If additional description is necessary, use BACK of this sheet)

Correspondence regarding this well should be addressed to Darby & Bothwell, Inc.
Address. 2003 Philtower Bldg., Tulsa, 3, Oklahoma.

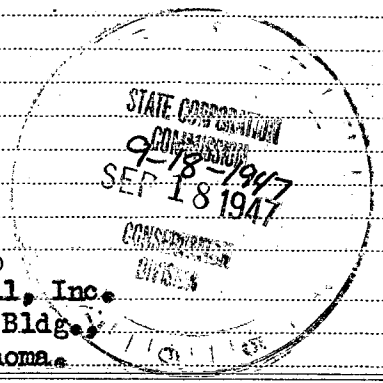

STATE OF Oklahoma COUNTY OF Tulsa, ss.
W. H. Barclay (employee of owner) of the above-described well,
being first duly sworn on oath, says: That I have knowledge of the facts, statements, and matters herein contained and the log of the above-described well as filed and that the same are true and correct. So help me God.

(Signature)

2003 Philtower Bldg., Tulsa, 3, Oklahoma.
(Address)

SUBSCRIBED AND SWORN to before me this 8th day of September, 1947.

My commission expires March 1, 1950.

Notary Public.

