

OR
FORMATION PLUGGING RECORD

Strike out upper line when reporting plugging off formations.

Give All Information Completely
Make Required Affidavit
Mail or Deliver Report to:
Conservation Division
State Corporation Commission
800 Bitting Building
Wichita, Kansas

Ellis County, Sec. 9 Twp. 12S Rge. (E) 18 (W)

Location as "NE $\frac{1}{4}$ NW $\frac{1}{4}$ SW $\frac{1}{4}$ " or footage from lines. NW NW SE

Lease Owner Globe Oil & Refining Co.

Lease Name Leikam "A" Well No. 1

Office Address 301 South Market, Wichita, Kansas

Character of Well (completed as Oil, Gas or Dry Hole) Dry Hole (Lost Surface Pipe)

Date well completed (Lost surface pipe - skidded location) 19

Application for plugging filed Verbal August 8, 19 52

Application for plugging approved (Written) August 11, 19 52


Plugging commenced August 8, 19 52

Plugging completed August 8, 19 52

Reason for abandonment of well or producing formation. Lost surface pipe on drilling test, therefore, skidded location.

If a producing well is abandoned, date of last production 19

Was permission obtained from the Conservation Division or its agents before plugging was commenced? Yes

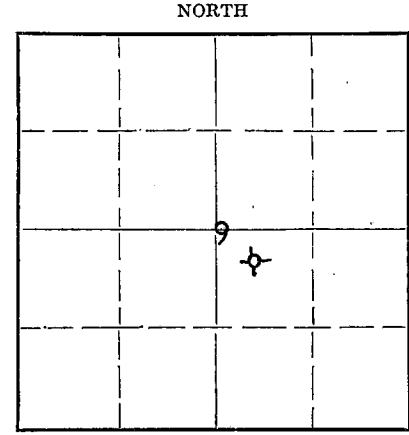

Locate well correctly on above Section Plat

Name of Conservation Agent who supervised plugging of this well Eldon Petty

Producing formation Depth to top Bottom Total Depth of Well 1484 Feet

Show depth and thickness of all water, oil and gas formations.

OIL, GAS OR WATER RECORDS

CASING RECORD

Formation	Content	From	To	Size	Put In	Pulled Out
				8 5/8"	(459' Lost in hole)	

Describe in detail the manner in which the well was plugged, indicating where the mud fluid was placed and the method or methods used in introducing it into the hole. If cement or other plugs were used, state the character of same and depth placed, from feet to feet for each plug set.

Pushed plug to 240 feet. Dumped 30 sacks cement. Filled with mud to 25 feet. Drove second plug to 25 feet and dumped 20 sacks cement on top as cap.

RECEIVED
CONSERVATION DIVISION
AUG 19 1952

CONSERVATION DIVISION
WICHITA, KANSAS

(If additional description is necessary, use BACK of this sheet)

Correspondence regarding this well should be addressed to Globe Oil & Refining Co.,
Address 301 South Market
Wichita, Kansas

STATE OF Kansas COUNTY OF Sedgwick, ss.

Leo Ross (employee of owner) or (owner or operator) of the above-described well, being first duly sworn on oath, says: That I have knowledge of the facts, statements, and matters herein contained and the log of the above-described well as filed and that the same are true and correct. So help me God.


(Signature) *Leo Ross*

301 South Market, Wichita, Kansas (Address)

SUBSCRIBED AND SWORN to before me this 18th day of August 19 52

My commission expires July 21, 1954

Frances Leslie
Notary Public.

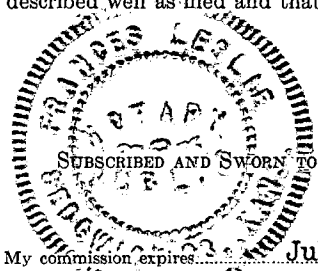

22-2625 2-48-15M
PLUGGING
FILE SEC 9 T 18 R 19
PAGE 36 LINE 34

15-051-19250-00-00
The Globe Oil & Refining Co.
Leikam 'A'.#1
NW NW SE Sec. 9-12-18W
Ellis County, Kansas

Drilling Commenced: 8-5-52
Drilling Completed: 8-8-52
Drilling Contractor: Group Exploration Co.
Total Depth: 1484'

Casing Record:
8 5/8" Casing parted at 990' -
459' left in hole

Formation:	Depth:
Shale & shells	275
Shale	600
Shale & shells	880
Sand	930
Sand & shale	1170
Shale & shells	1260
Shale & red bed	1474
Anhydrite	1484

Abandoned hole and skidded location
after surface casing parted.

PLUGGING
FILE SEC 9T18R18W
BOOK PAGE 36 LINE 34

RECEIVED
CONSERVATION COMMISSION
AUG 19 1952
CONSERVATION DIVISION
Wichita, Kansas