

STATE OF KANSAS
STATE CORPORATION COMMISSION

15-051-01118-00-00
WELL PLUGGING RECORD

Give All Information Completely
Make Required Affidavit
Mail or Deliver Report to:
Conservation Division
State Corporation Commission
212 North Market, Insurance Bldg.
Wichita, Kansas

Ellis County, Sec. 9 Twp. 12S Rge. 18W (XXX) (W)

Location as "NE/CNW/SW" or footage from lines SE SW NW

Lease Owner E. K. Edmiston

Lease Name K State Well No. #1

Office Address 802 Union National Bldg., Wichita, Kansas

Character of Well (completed as Oil, Gas or Dry Hole) dry hole

Date well completed 9-20-60 19

Application for plugging filed 9-20-60 19

Application for plugging approved 9-20-60 19

Plugging commenced 9-20-60 19


Plugging completed 9-20-60 19

Reason for abandonment of well or producing formation

commercial quantities of oil not found

If a producing well is abandoned, date of last production 19

Was permission obtained from the Conservation Division or its agents before plugging was commenced? yes

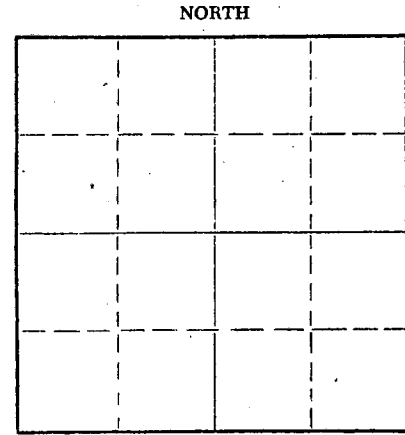

Locate well correctly on above Section Plat

Name of Conservation Agent who supervised plugging of this well Mr. Truan

Producing formation _____ Depth to top _____ Bottom _____ Total Depth of Well _____ Feet

Show depth and thickness of all water, oil and gas formations.

OIL, GAS OR WATER RECORDS

CASING RECORD

FORMATION	CONTENT	FROM	TO	SIZE	PUT IN	PULLED OUT
				8 5/8"	184'	none

Describe in detail the manner in which the well was plugged, indicating where the mud fluid was placed and the method or methods used in introducing it into the hole. If cement or other plugs were used, state the character of same and depth placed, from _____ feet to _____ feet for each plug set.

Plug and 20 sacks cement at 600 feet

Plug and 16 sacks at 180'

Plug @ 40 feet 1/2 sk hulls 10 sks cement to top

RECEIVED
STATE CORPORATION COMMISSION
9-27-1960
SEP 27 1960
CONSERVATION DIVISION
Wichita, Kansas

(If additional description is necessary, use BACK of this sheet)
Name of Plugging Contractor E. K. Edmiston Drilling Company, Inc.
Address 802 Union National Bldg., Wichita, Kansas


STATE OF Kansas, COUNTY OF Sedgwick, ss.
E. K. Edmiston (employee of contractor) of the above-described well, being first duly sworn on oath, says: That I have knowledge of the facts, statements and matters herein contained and the log of the above-described well as filed and that the same are true and correct. So help me God.

(Signature) _____
802 Union National Bldg., Wichita, Ks.
(Address)

SUBSCRIBED AND SWORN TO before me this 23rd day of September, 19 60

My commission expires June 25, 1964

Frances Marler
Notary Public.

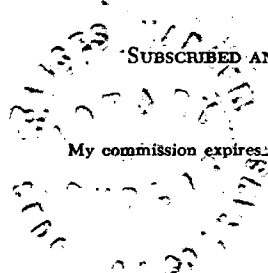

COMPANY: E. K. Edmiston
 802 Union National Bldg.
 Wichita 2, Kansas

Rotary Drilling Commenced: September 10, 1960

Rotary Drilling Completed: September 20, 1960

Well Name: K State #1
 SE SW NW 9-12S-18W
 Ellis County, Kansas

Contractor: E. K. Edmiston Drilling Co., Inc.
 802 Union Nat onal Bldg.
 Wichita, Kansas

Casing records: 8 5/8" @ 184' w/150 sacks

LOG


Measurements from top of Rotary Bushing:

Rocks & shells	0	- 95
Shale		186
Shale		1173
Red Bed & Shale		1485
Anhydrite		1520
Shale & Shells		2005
Shale		2125
Lime		2305
Lime Shale		2360
Shale & Lime		2455
Lime & Shale		2740
Shale & Shells		2800
Lime & Shale		3291
Lime		3326
Lime		3733
Lime		3769
Lime		3838 Rotary Total Depth

STATE OF KANSAS
 SEP 27 1960
 9-27-1960
 COMMERCIAL DIVISION
 Wichita, Kansas

The undersigned, E. K. Edmiston, President of the E. K. Edmiston Drilling Company, Inc., hereby certifies, in behalf of said company that the above log is a true and correct log of the formations encountered in drilling the above well as reflected by the Daily Drilling Reports.


E. K. Edmiston Drilling Co., Inc.

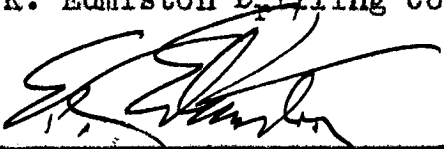By 
 E. K. Edmiston President

STATE OF KANSAS)
) ss
 COUNTY OF SEDGWICK)

BE IT REMEMBERED that, on this 23rd day of September, 1960, before me, the undersigned, a Notary Public duly commissioned in and for the State and County aforesaid, came E. K. Edmiston, known to me to be the same person who executed the foregoing instrument as President and in behalf of the E. K. Edmiston Drilling Company, Inc. and he duly acknowledged the execution of the same for himself and for said company.

IN WITNESS WHEREOF, I have hereunto set my hand and official seal on the day and year last above written.

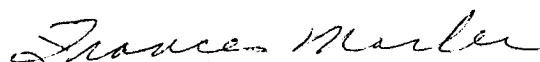
 Frances Marler Notary Public

My commission expires:
 June 25, 1964